IREDELL COUNTY HEALTH DEPARTMENT

STATESVILLE 704-878-5305 / 30.00 Paid MOORESVILLE 704-664-5281

IMPROVEMENT PERMIT / AUTHORIZATION TO CONSTRUCT / OPERATION PERMIT / EXISTING SYSTEM INSPECTION

PERMIT# 115332 PIN# 4654 37 3085 DATE 9/23/03

OWNER OR CONTRACTOR Lynne Oke PHONE: Business 704-896-1683 Home

ADDRESS 120 Rockwell Lp Mooresville NC. 28115

LOCATION Rockwell Lp. - 115 S RESERVE AREA TL Presbyterian Rd. TR Rockwell Lp. on (L) in Curve

SUBDIVISION N/A BLOCK / SECTION RESERVE AREA LOT 60 LOT AREA 1.19 AC SITE CLASS. PS DESIGN FLOW 480 L.T.A.R. .3

Septic Tank: 1000 Gallons; STB 794 Date 1/3/03
Pump Tank: Gallons; PT Date
Pump Make: Model Serial No.
Nitrification Field: No Fields 1 Square Feet 1200 Linear Feet 400
No Lines 5 @ 80' Trench Width 3' Max Trench Bottom Depth 30"


[X] New System [ ] Repair System Type: I, II, (III), IV, V, VI
System Description: Gravity - Type 3
Repair System Description: Pressure - Type 4
Maintenance Agreement Required: [ ] Yes [X] No

[X] House/Mod. Home No. Bedrooms 4
[ ] Mobile Home No. Bathrooms 3
[ ] Business No. Employees
[ ] Other
Gravel Depth N/A [ ] Slab [X] Crawl Space [ ] Basement w/plumbing [ ] Basement wo/plumbing

Water Supply: [X] Individual [ ] Public [ ] Community

Comments:/Conditions:

INITIAL SITE SKETCH

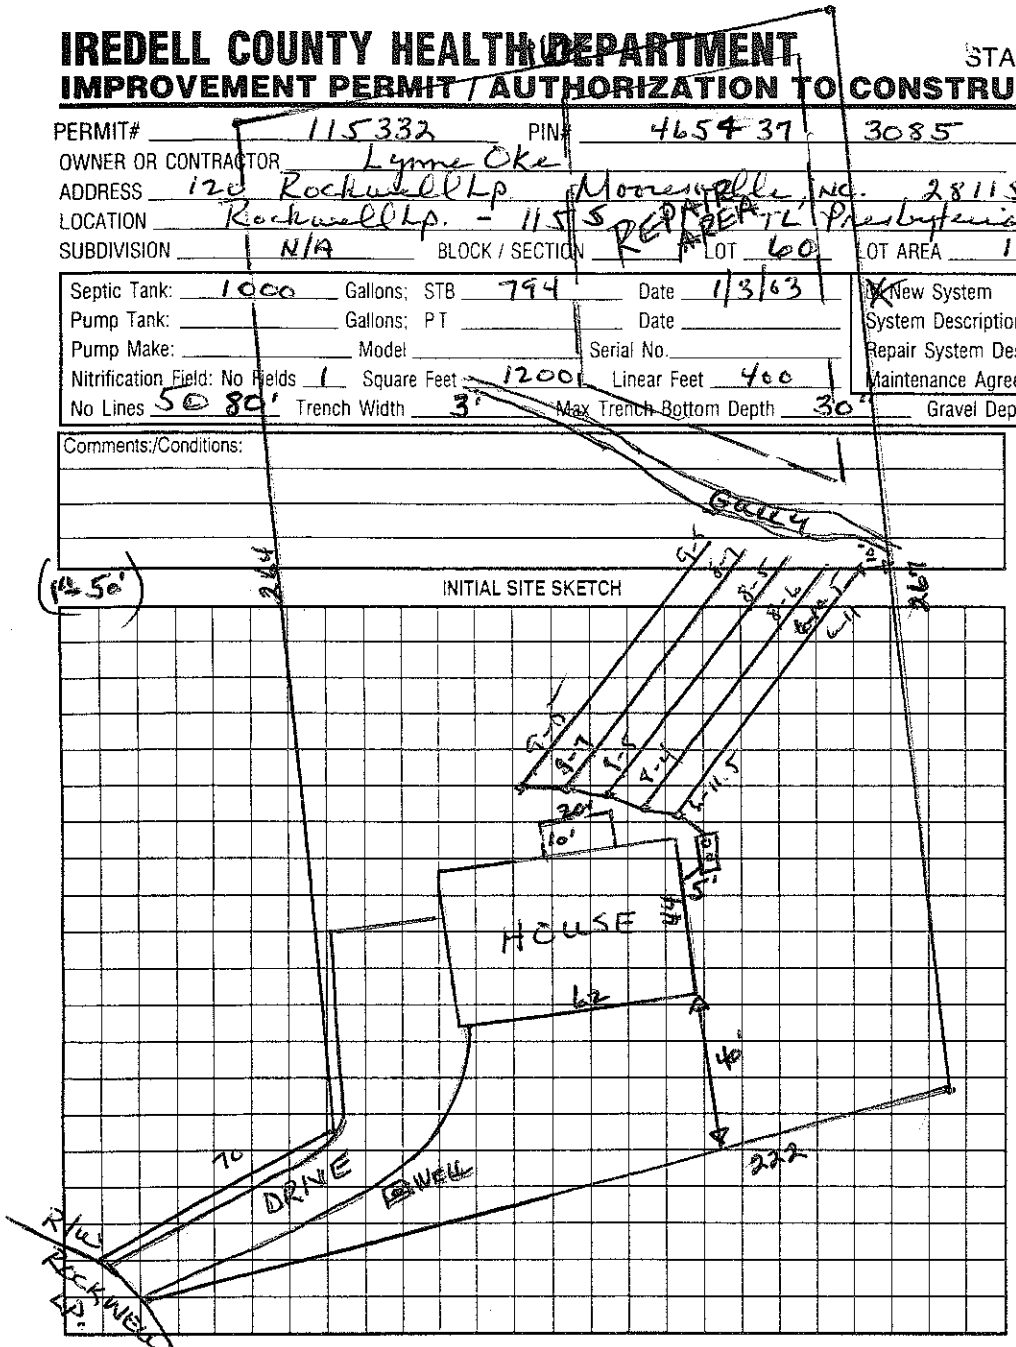

Comments:/Conditions:

AS BUILT SKETCH

Permit can be suspended or revoked if any false information is supplied toward securing the permit/any unauthorized changes are made to the site/any unauthorized changes are made in the installation of the system. Improvement Permit with plat valid without expiration. Improvement Permit with site plan valid for sixty months. Authorization to Construct is valid for a period equal to that of Improvement Permit – not to exceed sixty months.

Signed: Lynne Oke date 9/24/03 Installed by: Consolidated Grading

Improvement Permit by: Wesley Sparks R.S. date 9/23/03 Operation Permit by: Wesley Sparks R.S. date 12/23/03

Authorization to Construct by: Wesley Sparks R.S. date 9/23/03 Existing System Inspection by: date

HEALTH DEPT. COPY: WHITE OWNER COPY (FINAL): YELLOW OWNER COPY (INITIAL): PINK