250.00 Paid

IREDELL COUNTY HEALTH DEPARTMENT

STATESVILLE 704-878-5305 MOORESVILLE 704-664-5281

IMPROVEMENT PERMIT / AUTHORIZATION TO CONSTRUCT / OPERATION PERMIT / EXISTING SYSTEM INSPECTION

PERMIT# 137203 PIN# 4654 37 4175 DATE 8/3/06

OWNER OR APPLICANT RMR-ABI Investments LLC PHONE: Business 704-564-9007 Home

ADDRESS PO Box 903 Davidson, NC 28036

LOCATION 122 Rockwell Loop Mt Mourne, NC. 28123

SUBDIVISION Maidress Construction SECTION LOT 61-1 LOT AREA .83AC SITE CLASS. PS DESIGN FLOW 480 L.T.A.R. 125

Septic Tank: EXISTING Gallons; STB Date

Pump Tank: Gallons; PT Date

Pump Make: Model Serial No.

Nitrification Field: No Fields 1 Square Feet 720 Linear Feet 240

No Lines 2@120' Trench Width 3' Max Trench Bottom Depth 30"

☐ New System ☐ Repair, ☒ Expansion System Type: I II (III) IV V VI

System Description: Distbox - 2507 Reduct

Repair System Description:

Maintenance Agreement Required: ☐ Yes ☒ No

Gravel Depth NO ☒ Gravity ☐ Pressure

☒ House/Mod. Home ☐ Mobile Home ☐ Business ☐ Other

No. Bedrooms 4 No. Persons No. Employees


Water Supply: ☒ Individual ☐ Public ☐ Community EXISTING

☐ Slab ☒ Crawl Space ☐ Basement w/plumbing ☐ Basement wo/plumbing


Comments:/Conditions: Must add flow divider and 2 Distribution Boxes with 4 Speed Levelers to existing system on site now.

Comments:/Conditions: Installed as drawn

INITIAL SITE SKETCH

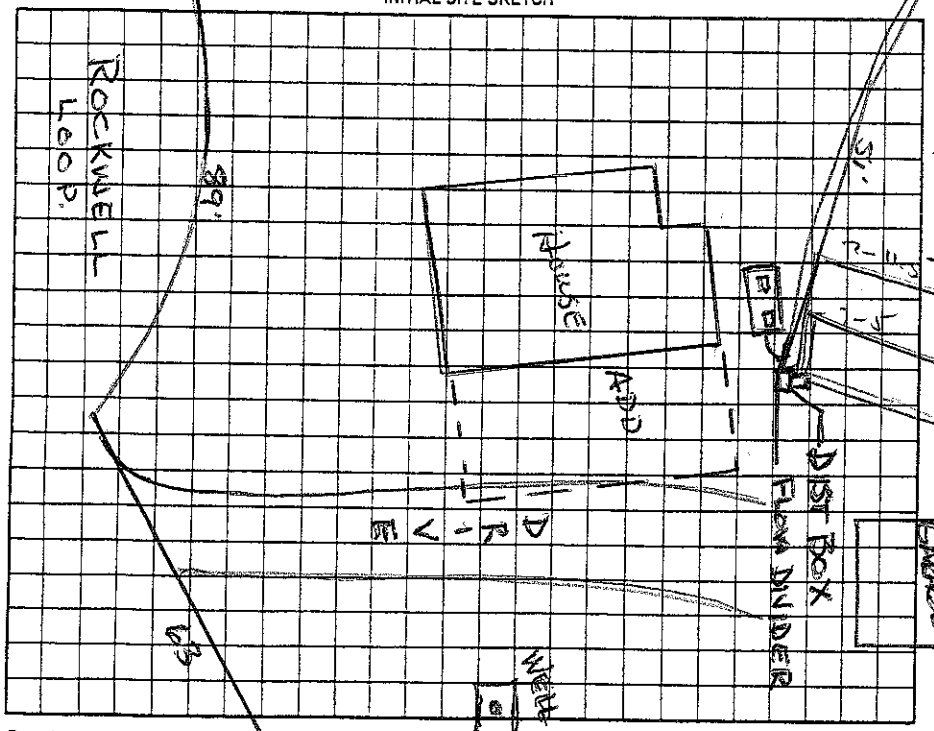

AS BUILT SKETCH

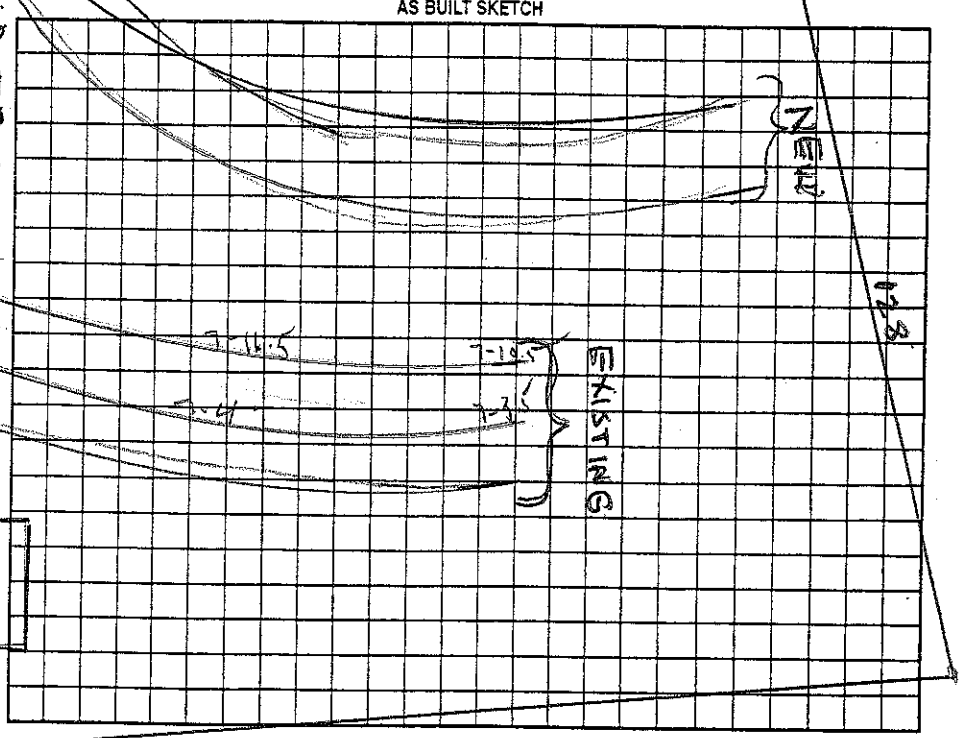

Permit can be suspended or revoked if any false information is supplied toward securing the permit/any unauthorized changes are made to the site/any unauthorized changes are made in the installation of the system. Improvement Permit with plat valid without expiration ☐ Improvement Permit with site plan valid for sixty months ☐ 2 1/2 Authorization to Construct is valid for a period equal to that of Improvement Permit – not to exceed sixty months.

Signed: [signature] date 8-7-06 Installed by: Steve Jordan - Piedmont Backhoe Tech

Improvement Permit by: Wesley Sparks R.S. date 8/3/06 Operation Permit by: Wesley Sparks R.S. date 10/3/06

Authorization to Construct by: Wesley Sparks R.S. date 8/3/06 Existing System Inspection by: date

HEALTH DEPT. COPY: WHITE OWNER COPY (FINAL): YELLOW OWNER COPY (INITIAL): PINK