IREDELL COUNTY HEALTH DEPARTMENT

4654480040

STATESVILLE 704-878-5305 MOORESVILLE 704-664-5281

IMPROVEMENT PERMIT / AUTHORIZATION TO CONSTRUCT / OPERATION PERMIT / EXISTING SYSTEM INSPECTION

PERMIT# 143746 PIN# 4654480040

OWNER OR APPLICANT Clayton Homes (Vincent Nathaniel) PHONE: Business (704) 941-5307 Home DATE 7/5/07

ADDRESS

LOCATION Hwy 115 S TL on Presbyterian Rd, .3miles on R 180 Presbyterian Rd.

SUBDIVISION Maitharee Cornelius BLOCK / SECTION LOT 90 LOT AREA SITE CLASS. DESIGN FLOW L.T.A.R.

Existing

Septic Tank: 1000 Gallons; STB Date

Pump Tank: Gallons; PT Date

Pump Make: Model Serial No.

Nitrification Field: No Fields 1 Square Feet 750 Ex Linear Feet 250'

No Lines 2 Trench Width 36" Max Trench Bottom Depth Gravel Depth 10"

☐ New System ☐ Repair ☐ Expansion System Type: I (II) III IV V VI

System Description: Existing Gravity

Repair System Description:

Maintenance Agreement Required: ☐ Yes ☐ No

☐ House/Mod. Home ☐ Mobile Home ☐ Business ☐ Other

No. Bedrooms 3 No. Persons No. Employees

Water Supply: ☐ Individual ☐ Public ☐ Community

☐ Gravity ☐ Pressure ☐ Slab ☐ Crawl Space ☐ Basement w/plumbing ☐ Basement wo/plumbing


Comments:/Conditions:

Comments:/Conditions: Existing System See permit #193 "1981"
Owner: Hayden W. Jones See attachment.
No visible malfunction observed 7/5/07.

INITIAL SITE SKETCH

NTS

AS BUILT SKETCH

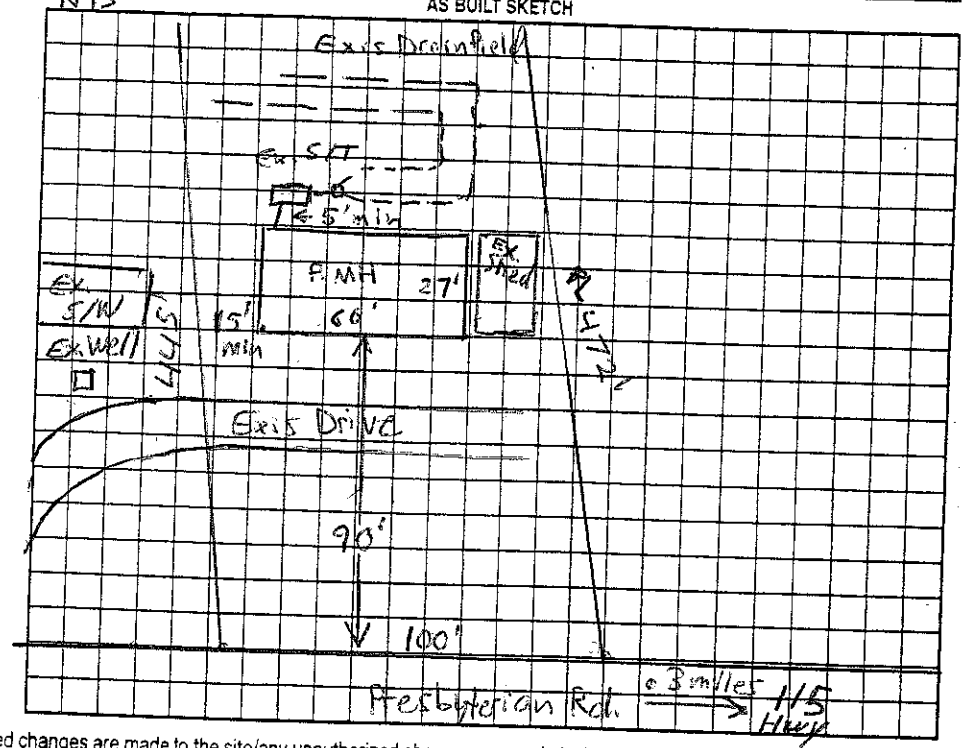

Permit can be suspended or revoked if any false information is supplied toward securing the permit/any unauthorized changes are made to the site/any unauthorized changes are made in the installation of the system. Improvement Permit with plat valid without expiration ☐ Improvement Permit with site plan valid for sixty months ☐ Authorization to Construct is valid for a period equal to that of Improvement Permit – not to exceed sixty months.

Signed: date 7-9-7

Improvement Permit by: date

Authorization to Construct by: date

Installed by:

Operation Permit by: date

Existing System Inspection by: Anthony Cobern Jr. date 7/9/07

HEALTH DEPT. COPY: WHITE OWNER COPY (FINAL): YELLOW OWNER COPY (INITIAL): PINK