# IREDELL COUNTY HEALTH DEPARTMENT

STATESVILLE 704-878-5305 MOORESVILLE 704-664-5281

## IMPROVEMENT PERMIT / AUTHORIZATION TO CONSTRUCT / OPERATION PERMIT / EXISTING SYSTEM INSPECTION

PERMIT# 108372 PIN# 4654481041 DATE 8-28-2002

OWNER OR CONTRACTOR Rusty Knox / Cindy Baugus PHONE: Business 497-5552 Home

ADDRESS P.O. Box 40 Davidson NC 28036

LOCATION Hwy 115 South TL Presbyterian Rd ~3/4 mile on right

SUBDIVISION BLOCK / SECTION LOT LOT AREA .99 Acre SITE CLASS. #5 DESIGN FLOW 360gpd L.T.A.R.

Septic Tank: 1000 Gallons; STB Date

Pump Tank: Gallons; PT Date

Pump Make: Model Serial No.

Nitrification Field: No Fields 1 Square Feet 750 Linear Feet 250

No Lines 4 Trench Width 12 Bed Max Trench Bottom Depth Gravel Depth 16" + ☐ Slab ☒ Crawl Space ☐ Basement w/plumbing ☐ Basement wo/plumbing

☐ New System ☐ Repair System Type: I II III IV V VI

System Description: Existing Gravity-Conventional

Repair System Description:

Maintenance Agreement Required: ☐ Yes ☐ No

☐ House/Mod. Home ☒ Mobile Home ☐ Business ☐ Other


No. Bedrooms 3 No. Bathrooms 2 No. Employees

Water Supply: ☒ Individual ☐ Public ☐ Community

Comments/Conditions: Existing Septic System appears to be functioning okay at time of inspection, No problems noticed

Comments/Conditions: Note: Advised owner to remove portable shed off drainfield Keep New MH at least 5' from Existing Septic system

INITIAL SITE SKETCH ☒ Not to Scale

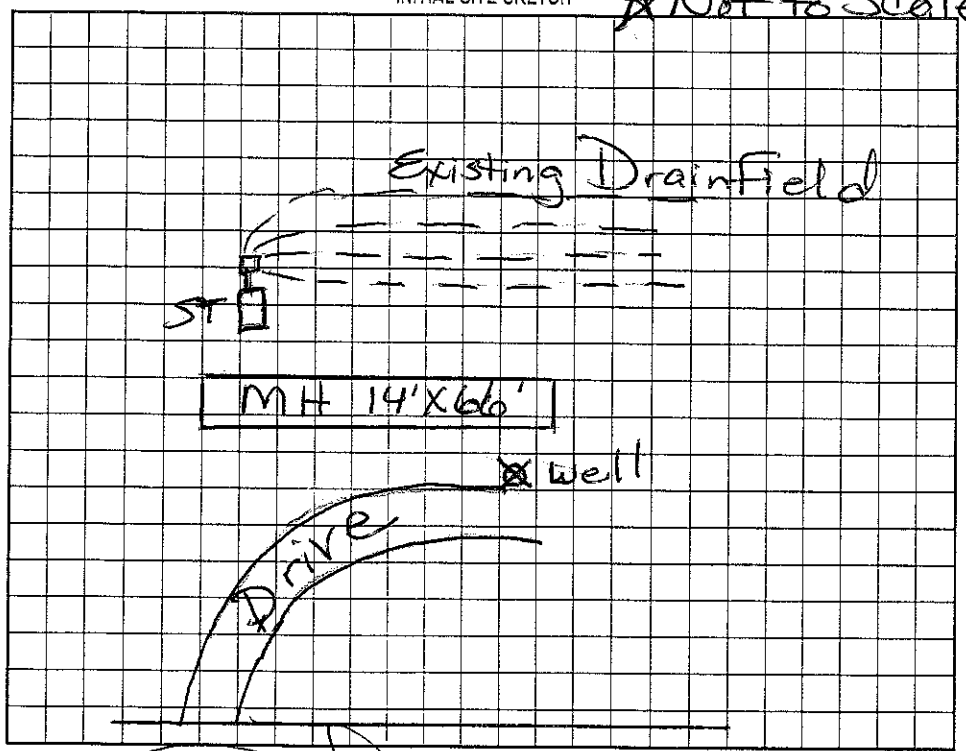


AS BUILT SKETCH

Installed Septic in 1981 Under Hayden Jones.

Permit can be suspended or revoked if any false information is supplied toward securing the permit/any unauthorized changes are made to the site/any unauthorized changes are made in the installation of the system. Improvement Permit with plat valid without expiration. Improvement Permit with site plan valid for sixty months. Authorization to Construct is valid for a period equal to that of Improvement Permit – not to exceed sixty months.

Signed: date Installed by:

Improvement Permit by: Maria H. Hutchinson R.S. date 8/28/2002 Operation Permit by: date

Authorization to Construct by: date Existing System Inspection by: Maria H. Hutchinson R.S. date 8/28/2002

HEALTH DEPT. COPY: WHITE OWNER COPY (FINAL): YELLOW OWNER COPY (INITIAL): PINK