IREDELL COUNTY HEALTH DEPARTMENT

STATESVILLE 704-878-5305 MOORESVILLE 704-663-5281

IMPROVEMENT PERMIT / AUTHORIZATION TO CONSTRUCT / OPERATION PERMIT / EXISTING SYSTEM INSPECTI

130.00 Paid

DATE 6/18/03

PERMIT# 113635 PIN# 4654-49-0133.145 4654490133

OWNER OR CONTRACTOR Wood Lawn School PHONE: Business 8695-8653 Home

ADDRESS 145 Woodlawn school Lt. Mooresville NC 28115

LOCATION 1155, TL Presbyterian Rd, TL Woodlawn Sch System on Lt of Presbyterian Rd

SUBDIVISION BLOCK / SECTION LOT LOT AREA 60+AC SITE CLASS PS DESIGN FLOW 450 L.T.A.R. 0.3

Water Supply: ☒ Individual ☐ Public ☐ Community

☐ House/Mod. Home No. Bedrooms
☐ Mobile Home No. Bathrooms
☐ Business No. Employees
☒ Other Classroom 45 Students

Septic Tank: 1000 Gallons: STB 324 Date 5/21/03

Pump Tank: 1000 Gallons: PT 450 Date 7/3/03

Pump Make: ZOELLER Model N153-A Serial No.

Nitrification Field: No Fields 1 Square Feet 1200 Linear Feet 400

No Lines 5@80' Trench Width 36" Max Trench Bottom Depth 36"

☒ New System ☐ Repair System Type: I, II, III, IV, V, VI

System Description: Press. Man. 25% Reduction

Repair System Description: 25% Reduction

Maintenance Agreement Required: ☐ Yes ☒ No

☒ Slab ☐ Crawl Space ☐ Basement w/plumbing ☐ Basement wo/plumbing


Gravel Depth

Comments/Conditions: * Supply Line Needs to be ⊗ Sleeved and/or 30" below Future ⊗ Drive ⊗ Well

Comments/Conditions:

P/L

INITIAL SITE SKETCH

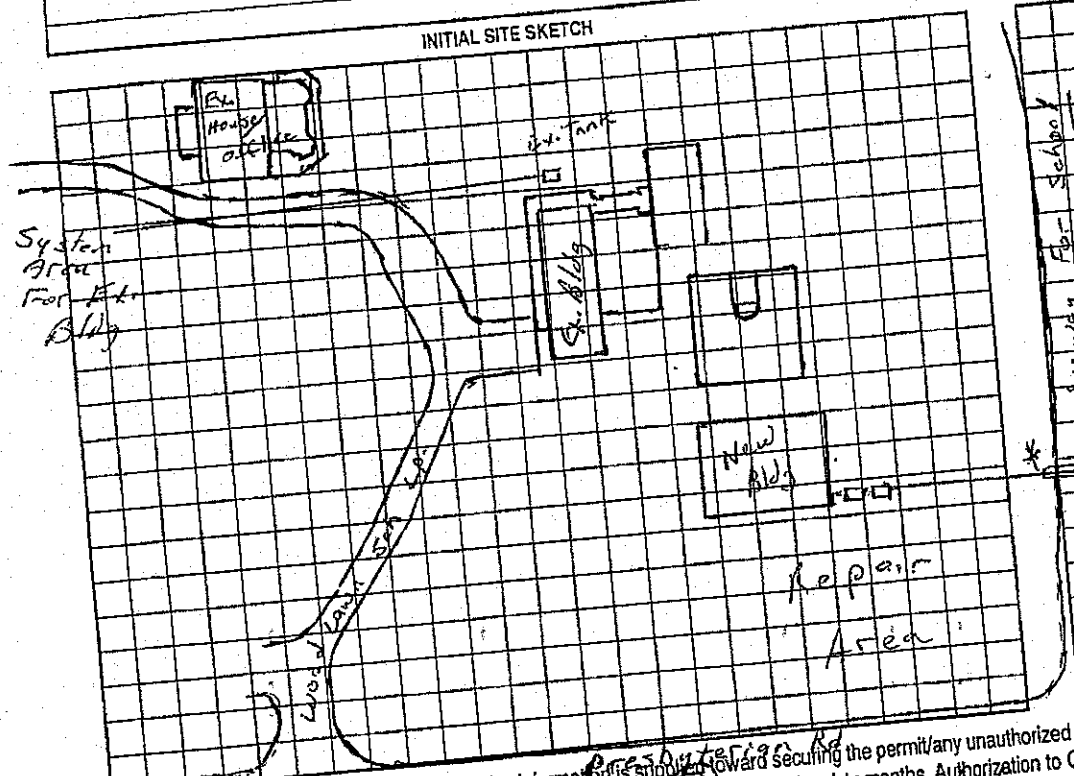

AS BUILT SKETCH



Permit can be suspended or revoked if any false information is supplied toward securing the permit/any unauthorized changes are made to the site/any unauthorized changes are made in the installation of the system. Impr

Permit with plat valid without expiration. Improvement Permit with site plan valid for sixty months. Authorization to Construct is valid for a period equal to that of Improvement Permit – not to exceed sixty months.

Signed: [signature] date 6/9/03

[signature] RS date 6/18/03

Installed by: Dennis Willis Septic Service

Operation Permit by: [signature] LS date 8/28

Existing System Inspection by: date