IREDELL COUNTY HEALTH DEPARTMENT

STATESVILLE 704-878-~~5205~~ 2800 ext 3, 4 MOORESVILLE 704-664-5281

IMPROVEMENT PERMIT / AUTHORIZATION TO CONSTRUCT / OPERATION PERMIT / EXISTING SYSTEM INSPECTION

DATE 6/2/05

PERMIT# 128749 PIN# 4654-49-0133

OWNER OR CONTRACTOR Woodlawn School PHONE: Business 704-622-2725 Home

ADDRESS 145 Woodlawn school Lp Mooresville NC 28115

LOCATION 115 S, TL Presbyterian, on Lt.

SUBDIVISION BLOCK / SECTION LOT LOT AREA 60+ Ac SITE CLASS. PS DESIGN FLOW *300 L.T.A.R. 0.3

Septic Tank: 1500 Gallons: STB 6'2 Date 6/14/05

Pump Tank: ~~1500~~ 1000 Gallons: Existing Date

Pump Make: Existing Model Serial No.

Nitrification Field: No Fields 1 Square Feet 780 Add'l Linear Feet 400' Add'l

No Lines 3 @ 80' Trench Width 36" Max Trench Bottom Depth 36" Gravel Depth

☒ New System ☐ Repair System Type: I, II, (III), IV, V, VI

System Description: PM 25% Reduction

Repair System Description: Same

Maintenance Agreement Required: ☐ Yes ☒ No

☐ House/Mod. Home No. Bedrooms

☐ Mobile Home No. Bathrooms

☐ Business No. Employees

☒ Other Classroom 30 students

☐ Slab ☒ Crawl Space ☐ Basement w/plumbing ☐ Basement wo/plumbing


Water Supply: ☐ Individual ☐ Public ☐ Community

Comments/Conditions: Alternative Method used to size PT


Comments/Conditions: Building Plumbed to 1500
1500 to 1000 to PT

*Total Design Flow is 750 gpd

INITIAL SITE SKETCH

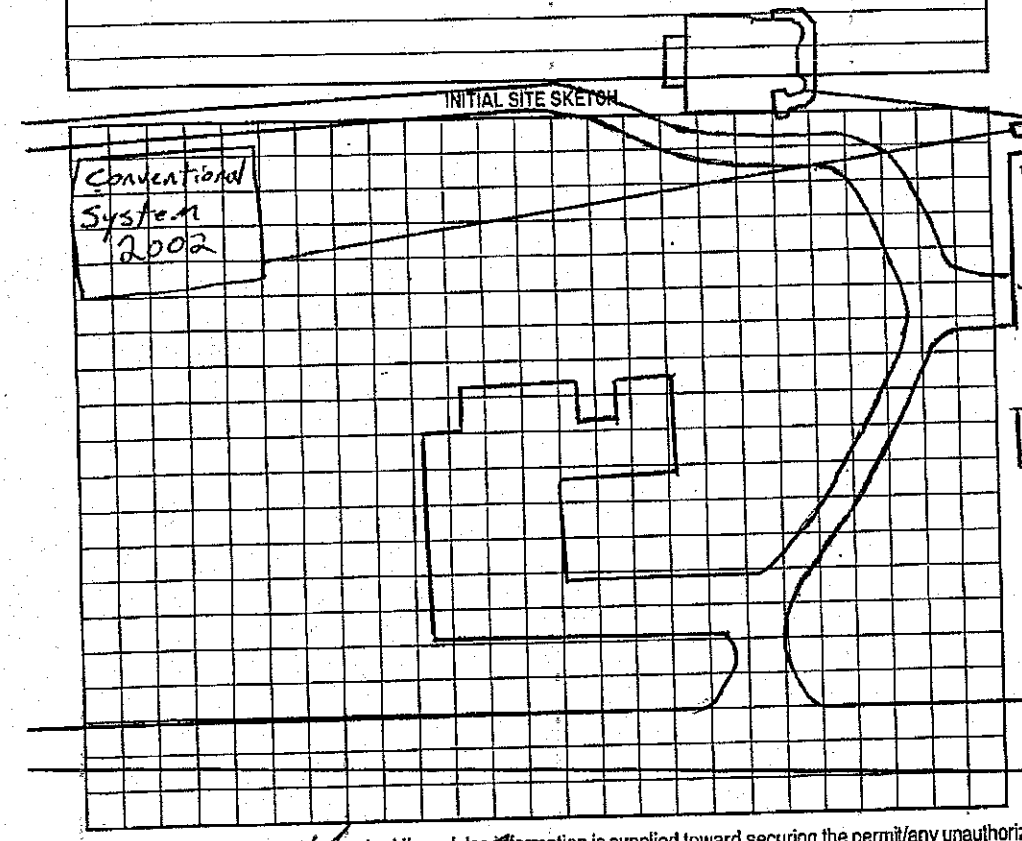

AS BUILT SKETCH

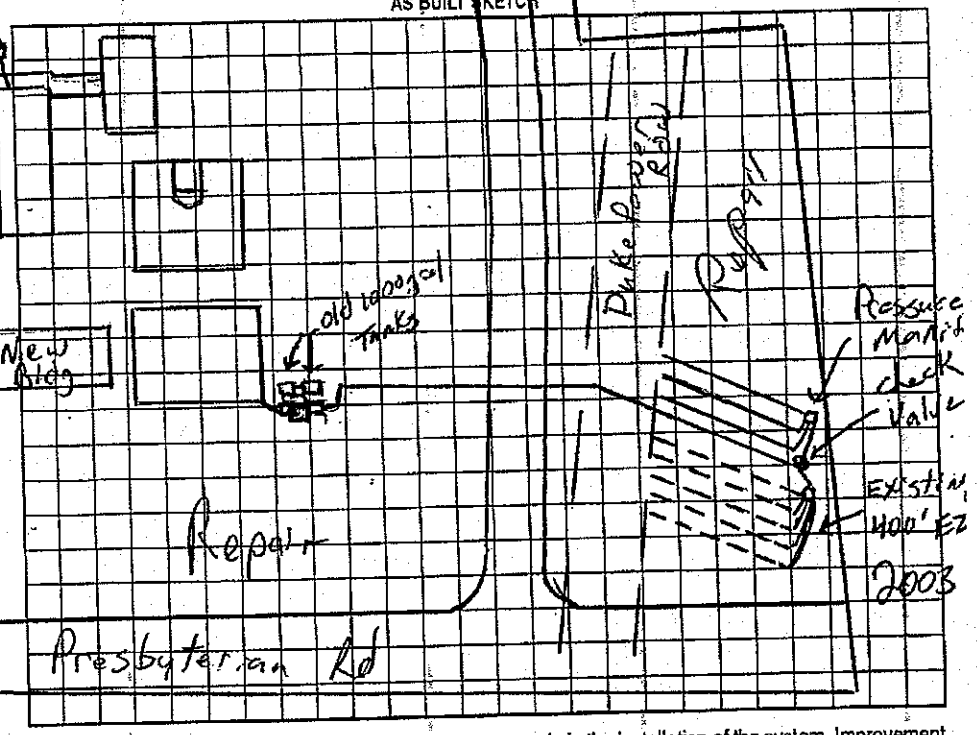

Permit can be suspended or revoked if any false information is supplied toward securing the permit/any unauthorized changes are made to the site/any unauthorized changes are made in the installation of the system. Improvement Permit with plat valid without expiration. Improvement Permit with site plan valid for sixty months. Authorization to Construct is valid for a period equal to that of Improvement Permit – not to exceed sixty months.

Signed: date 6-13-05

Improvement Permit by: RS date 6/2/05

Authorization to Construct by: RS date 6/2/05

Installed by: Dennis Willis Septic

Operation Permit by: RS date 8/24/05

Existing System Inspection by: date

HEALTH DEPT COPY: WHITE OWNER COPY (FINAL): YELLOW OWNER COPY (INITIAL): PINK