IREDELL COUNTY HEALTH DEPARTMENT

STATESVILLE 704-878-5305 MOORESVILLE 704-664-5281

IMPROVEMENT PERMIT / AUTHORIZATION TO CONSTRUCT / OPERATION PERMIT / EXISTING SYSTEM INSPECTION

PERMIT# 141853 PIN# 4654 49 0133 DATE 5/21/07

OWNER OR APPLICANT Woodlawn School – Ed Bowman PHONE: Business 704 655 9281 Home

ADDRESS 131 Woodlawn School Loop Mooresville, NC. 28115

LOCATION 115 S TL Presbyterian Rd. TL 1st Woodlawn School LP, 1st New Drive on (L) 1000

SUBDIVISION Woodlawn School BLOCK / SECTION LOT LOT AREA ~57 Ac. SITE CLASS. PS DESIGN FLOW ~~750~~ 1000 L.T.A.R. .3

Septic Tank: ~~1500~~ 2000 Gallons STB #4 Date 3/10/08

Pump Tank: ~~1500~~ 2000 Gallons #42 Date 4/2/08

Pump Make: Goulds Model 10EG 7TH (?) Serial No. 368

Nitrification Field: No Fields 1 Square Feet 2100 Linear Feet 833 ACLS

No Lines 8 @ 104 Trench Width 3' Max Trench Bottom Depth 3' Gravel Depth NO ☐ Gravity ☒ Pressure ☒ Slab ☐ Crawl Space ☐ Basement w/plumbing ☐ Basement wo/plumbing

☒ New System ☐ Repair ☐ Expansion System Type: I II (III) IV V VI

System Description: PM → 25% Reduction

Repair System Description: 25% Red, below old barn

Maintenance Agreement Required: ☐ Yes ☒ No

☐ House/Mod. Home ☐ Mobile Home ☐ Business ☒ Other 75 Student School

No. Bedrooms ___ No. Persons ___ No. Employees ___

Water Supply: ☒ Individual ☐ Public ☐ Community


Comments:/Conditions: Repair area below old barn (shed) on opposite side of soccer field.
8/16/07 – Design flow increased to 1000 GPD.

Comments:/Conditions:

(1" = 60)

INITIAL SITE SKETCH

AS BUILT SKETCH

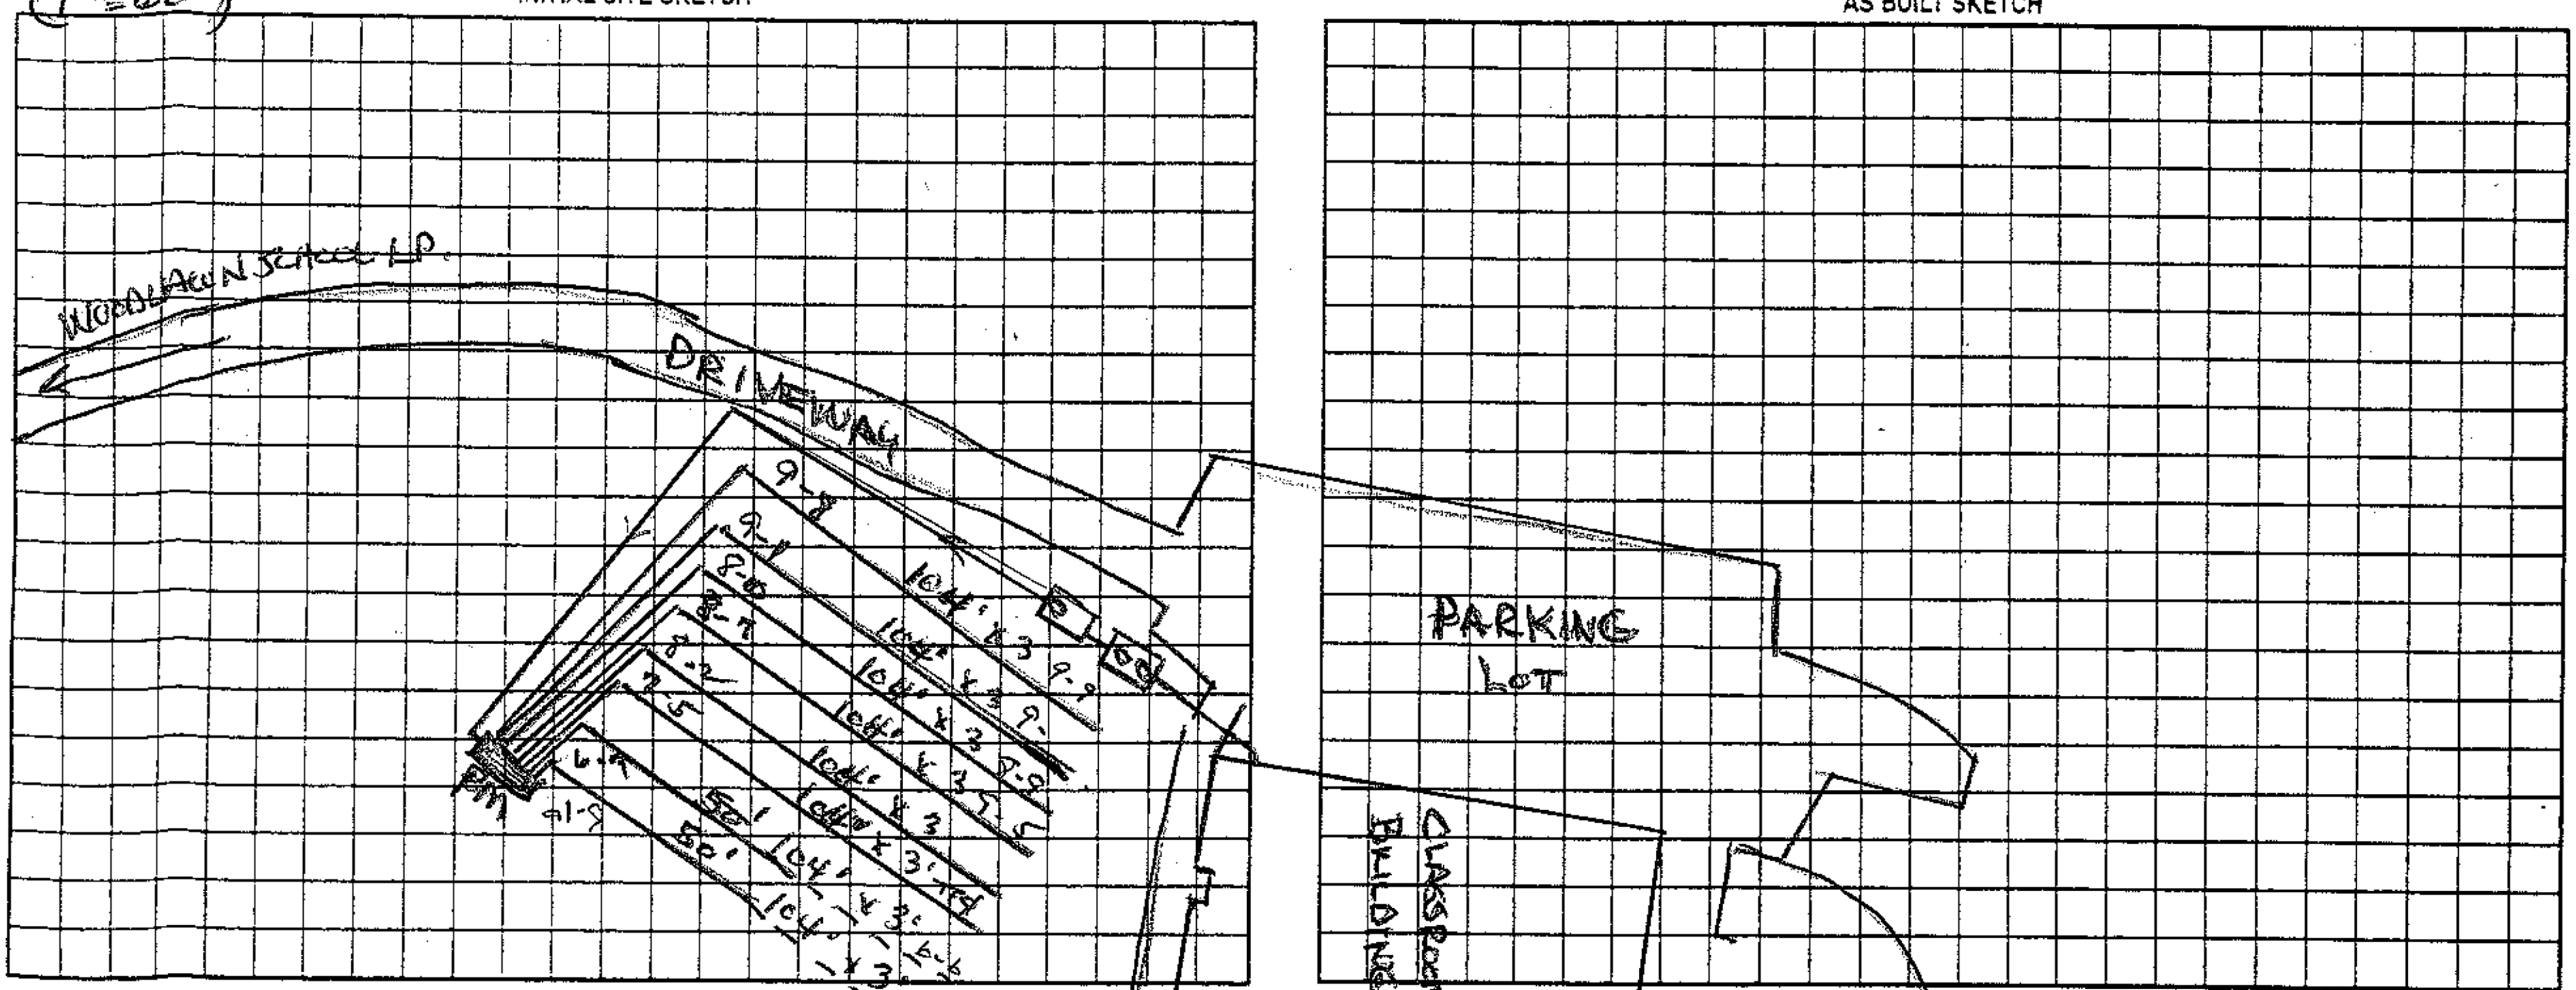

Permit can be suspended or revoked if any false information is supplied toward securing the permit/any unauthorized changes are made to the site/any unauthorized changes are made in the installation of the system. Improvement Permit with plat valid without expiration ☐ Improvement Permit with site plan valid for sixty months ☐ Authorization to Construct is valid for a period equal to that of Improvement Permit – not to exceed sixty months.

[signature] date 6/19/07

Permit by: Wesley Sparks R.S. date 5/21/07


To Construct by: Wesley Sparks RS date 5/21/07

Installed by: Orbison & Sons.

Operation Permit by: Wesley Sparks R.S. date 5/23/08

Existing System Inspection by: ______ date ______

HEALTH DEPT. COPY: WHITE OWNER COPY (FINAL): YELLOW OWNER COPY (INITIAL): PINK

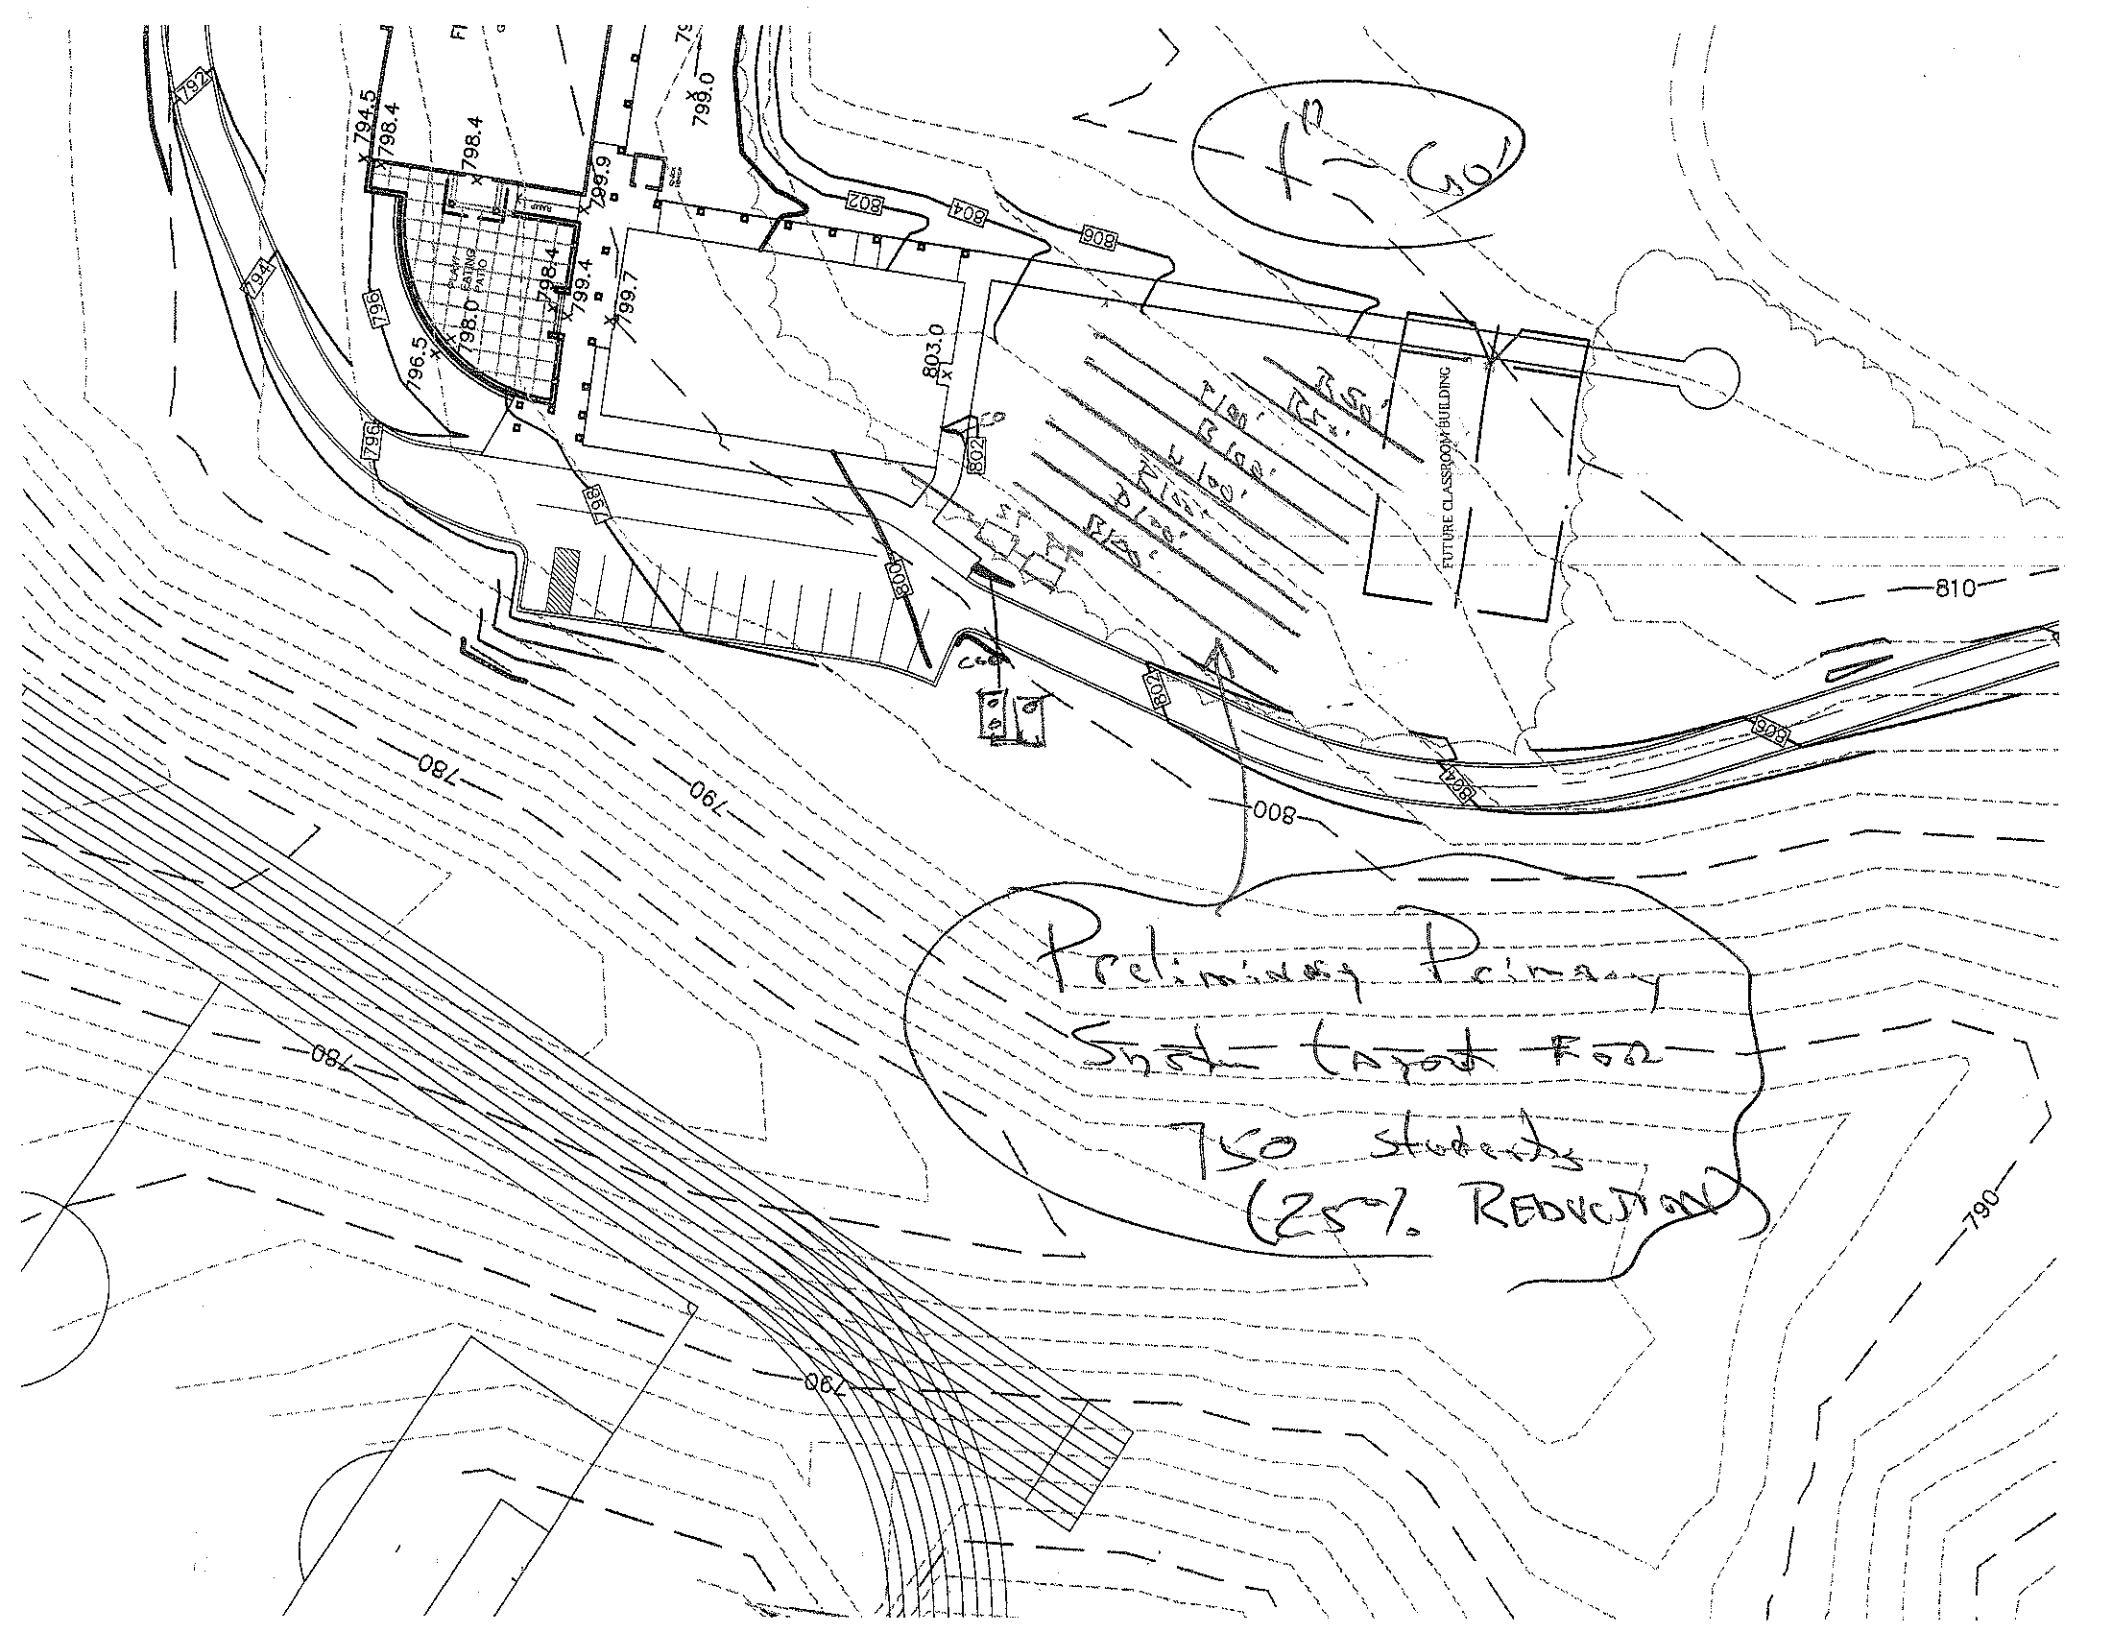
1" = 50'
FUTURE CLASSROOM BUILDING
PLAY EATING PATIO
Preliminary Primary System Layout For 750 students (25% REDUCTION)