IREDELL COUNTY HEALTH DEPARTMENT

STATESVILLE 704-878-5305 MOORESVILLE 704-664-5281

IMPROVEMENT PERMIT / AUTHORIZATION TO CONSTRUCT / OPERATION PERMIT / EXISTING SYSTEM INSPECTION

DATE 5/21/07

PERMIT# 141253 PIN# 4654 49 0133

OWNER OR APPLICANT WOODLAWN SCHOOL - ED BOWMAN PHONE: Business 704 655 9281 Home

ADDRESS 131 WOODLAWN SCHOOL LOOP MOORESVILLE, NC. 28115

LOCATION 115 S TL PRESBYTERIAN RD. TL 1ST WOODLAWN SCHOOL LP, 1ST NEW DRIVE ON (L) 1000

SUBDIVISION WOODLAWN SCHOOL BLOCK / SECTION LOT LOT AREA ~57 AC. SITE CLASS. PS DESIGN FLOW ~~750~~ L.T.A.R. .3

Septic Tank: ~~1500~~ 2000 Gallons SN 74 Date 3/10/08

Pump Tank: ~~1500~~ 2000 Gallons SN 142 Date 4/2/08

Pump Make: GOULDS Model VSC 11/2HP Serial No. 3/08 833 MLS

Nitrification Field: No Fields 1 Square Feet 2100 Linear Feet 833

No Lines 8 @ 104' Trench Width 3' Max Trench Bottom Depth 3'

☒ New System ☐ Repair ☐ Expansion System Type: I II III IV V VI

System Description: PM → 25% REDUCTION

Repair System Description: 25% RED, BELOW OLD BARN

Maintenance Agreement Required: ☐ Yes ☒ No

☐ House/Mod. Home No. Bedrooms

☐ Mobile Home No. Persons

☐ Business No. Employees

☒ Other 75 STUDENT SCHOOL


Water Supply: ☒ Individual ☐ Public ☐ Community

Gravel Depth NO ☐ Gravity ☒ Pressure ☒ Slab ☐ Crawl Space ☐ Basement w/plumbing ☐ Basement wo/plumbing


Comments:/Conditions: Repair area between old barn (shed) on opposite side of Soccer Field.
8/10/07 - Design flow increased to 1000 GPD.

Comments:/Conditions:

INITIAL SITE SKETCH (1" = 60')

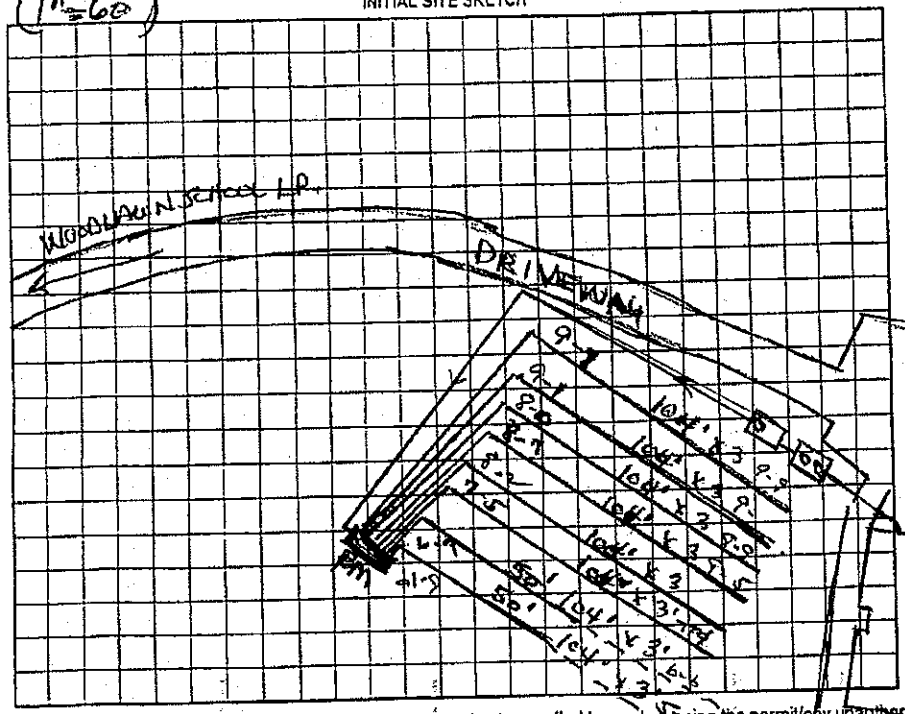

AS BUILT SKETCH

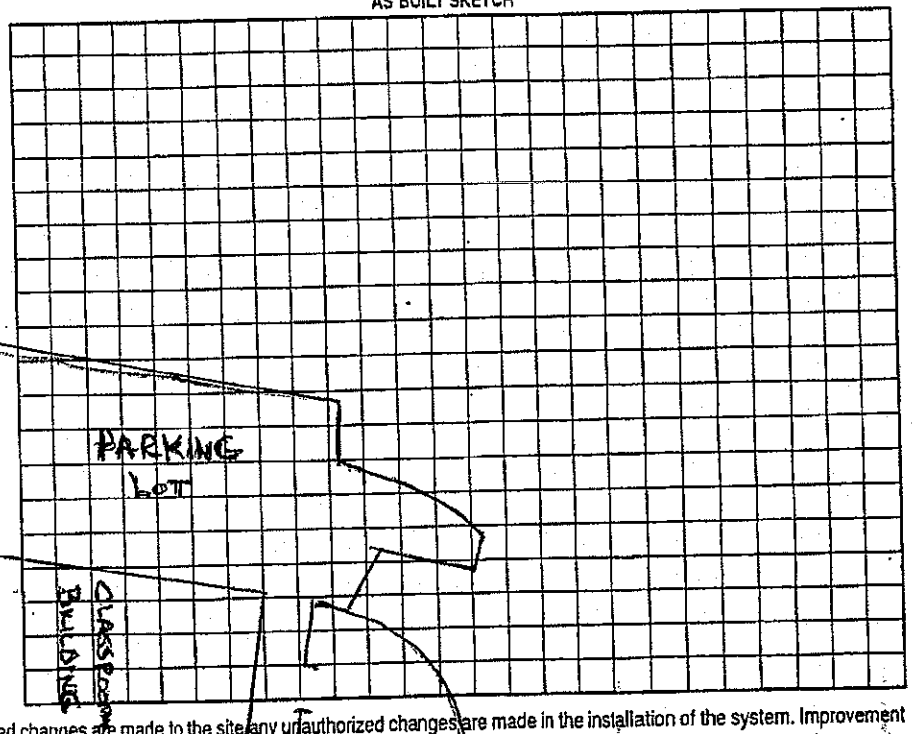

Permit can be suspended or revoked if any false information is supplied toward securing the permit/any unauthorized changes are made to the site/any unauthorized changes are made in the installation of the system. Improvement Permit with plat valid without expiration ☐ Improvement Permit with site plan valid for sixty months ☐ Authorization to Construct is valid for a period equal to that of Improvement Permit – not to exceed sixty months.

Signed: [signature] date 6/19/07

Improvement Permit by: Wesley Sparks RS date 5/21/07

Authorization to Construct by: Wesley Sparks RS date 5/21/07

Installed by: Ordonez & Sons

Operation Permit by: Wesley Sparks RS date 5/23/08

Existing System Inspection by: date

HEALTH DEPT. COPY: WHITE OWNER COPY (FINAL): YELLOW OWNER COPY (INITIAL): PINK