4654491832

IREDELL COUNTY HEALTH DEPARTMENT

STATESVILLE 704-878-5305 MOORESVILLE 704-664-5281

IMPROVEMENT PERMIT / CERTIFICATE OF COMPLETION / OPERATION PERMIT / EXISTING SYSTEM INSPECTION

PROPERTY DESCRIPTION NO. 21441 DATE 6/22/95 TAX MAP NO. 1C A 44 Watershed: ☒ Yes ☐ No

OWNER OR CONTRACTOR Roger Johnson PHONE: Business _____ Home 892-7568

ADDRESS 474 Mooresville Lake Rd. Mooresville, NC. 28115

LOCATION before 7th House on (L)

SUBDIVISION N/A BLOCK / SECTION _____ LOT N/A LOT AREA ~.75 Ac SITE CLASS. P DESIGN FLOW 240 L.T.A.R. _____

Septic Tank: 1000 Gallons; STB 794 Date 5/24/95

Pump Tank: _____ Gallons; PT _____ Date _____

Pump Make: _____ Model _____ Serial No. _____

Nitrification Field: No Fields 1 Square Feet 685 Linear Feet 171 (214)

No Lines 2 Trench Width 36" Max Trench Bottom Depth 32" Gravel Depth N/A

☒ New System ☐ Repair System Type: I, II, (III), IV, V, VI

System Description: INFILTRATOR - GRAVITY

Repair System Description: SAME

Maintenance Agreement Required: ☐ Yes ☒ No

☐ House/Mod. Home No. Bedrooms 3

☒ Mobile Home No. Bathrooms 2

☐ Business No. Employees _____

☐ Other _____


☐ Slab ☒ Crawl Space ☐ Basement w/plumbing ☐ Basement wo/plumbing

Water Supply: ☒ Individual ☐ Community ☐ Public

Comments: * 25% reduction for infiltrators use

Comments:

INITIAL SITE SKETCH

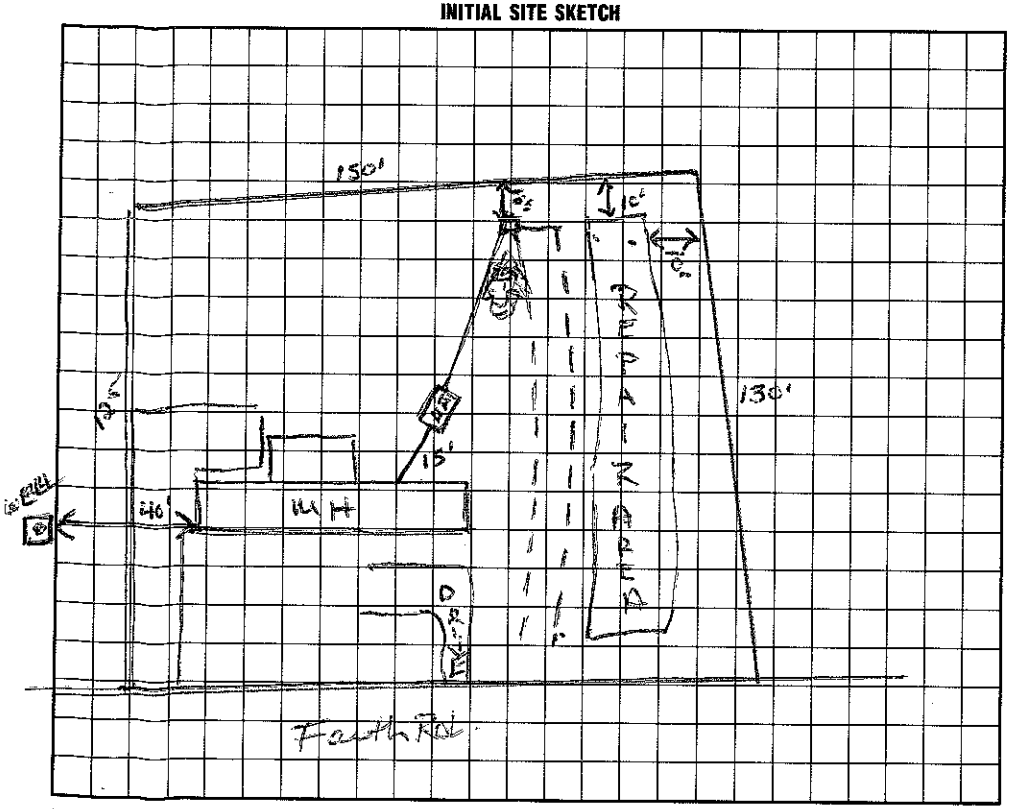

AS BUILT SKETCH

I understand that this permit can be suspended or revoked if any false information is supplied toward securing the permit/any unauthorized changes are made to the site/any unauthorized changes are made in the installation of the system. Improvement Permit is valid for 60 months from date of issuance.

Signed: Roger Johnson

Improvement Permit by: Wesley Sparks RS date 6/22/95

Existing System Inspection by: _____ date _____

Installed by: FT Irwin

Certificate of Completion by: Wesley Sparks RS. date 7/26/95

Operation Permit by: _____ date _____

HEALTH DEPT. COPY: WHITE INSPECTION COPY (FINAL): GREEN OWNER COPY (FINAL): YELLOW INSPECTION COPY (INITIAL): PINK OWNER COPY (INITIAL): GOLD