4654569946

IREDELL COUNTY HEALTH DEPARTMENT

STATESVILLE 704-878-5305 MOORESVILLE 704-664-5281

IMPROVEMENT PERMIT / CERTIFICATE OF COMPLETION / OPERATION PERMIT / EXISTING SYSTEM INSPECTION

PROPERTY DESCRIPTION NO. 19021 DATE 6/15/94 TAX MAP NO. IC A 43 Watershed: ☑ Yes ☐ No

OWNER OR CONTRACTOR Robbie Johnson PHONE: Business 892-9835 Home

ADDRESS Rt 1 Box 240 Mooresville, NC. 28115

LOCATION Presbyterian Rd, n. 7 mile from 1155 on (R) in Hoyfield

SUBDIVISION No BLOCK / SECTION LOT LOT AREA average SITE CLASS. P DESIGN FLOW 240 L.T.A.R. .3-.35

Septic Tank: 1000 Gallons; STB 794 Date 6/23/94

Pump Tank: Gallons; PT Date

Pump Make: Model Serial No.

Nitrification Field: No Fields 1 Square Feet 900 Linear Feet 300

No Lines 3 Trench Width 3' Max Trench Bottom Depth 30" Gravel Depth 12"

☑ New System ☐ Repair System Type: I (II) III, IV, V, VI

System Description: CONV - DIST BOX

Repair System Description: SAME

Maintenance Agreement Required: ☐ Yes ☐ No

☐ House/Mod. Home ☑ Mobile Home ☐ Business ☐ Other

No. Bedrooms 2 No. Bathrooms 2 No. Employees


☐ Slab ☑ Crawl Space ☐ Basement w/plumbing ☐ Basement wo/plumbing

Water Supply: ☑ Individual ☐ Community ☐ Public

Comments: Trench bottom 30" - Lines on slope contour. Drop Boxes may be used on this site.

Comments: Installed as drawn.

INITIAL SITE SKETCH

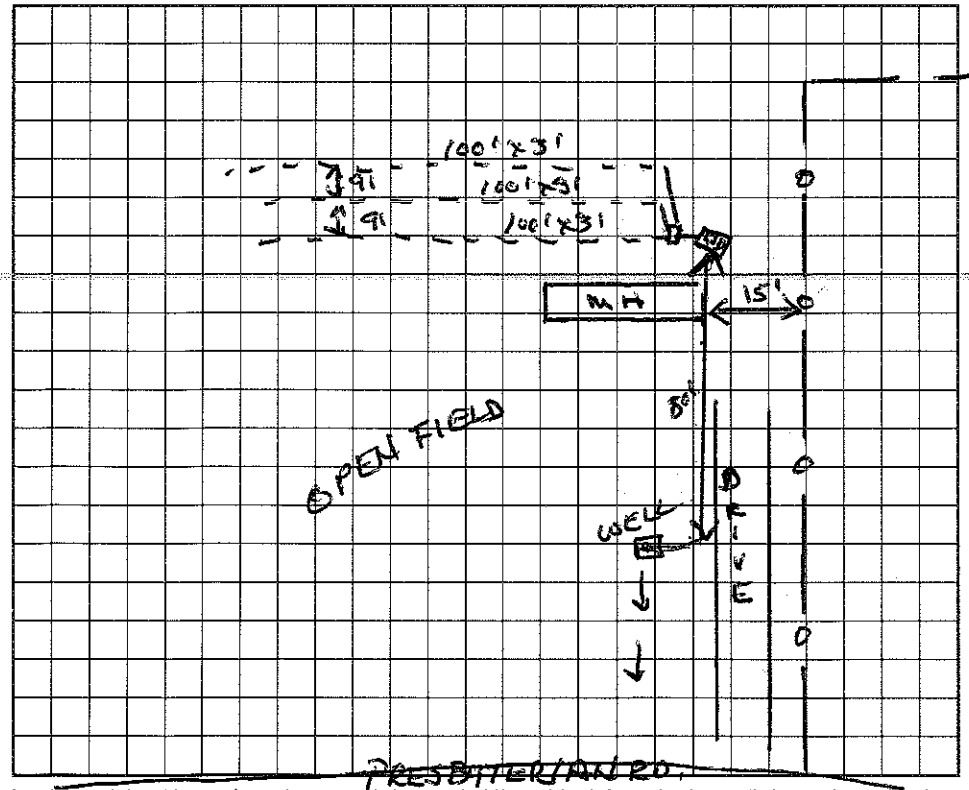

AS BUILT SKETCH

I understand that this permit can be suspended or revoked if any false information is supplied toward securing the permit/any unauthorized changes are made to the site/any unauthorized changes are made in the installation of the system. Improvement Permit is valid for 60 months from date of issuance.

Signed: ~~Wesley Sparks RS~~ Robbie Johnson

Improvement Permit by: Wesley Sparks RS. date 6/15/94

Existing System Inspection by: date

Installed by: Phifer Johnson.

Certificate of Completion by: Wesley Sparks RS. date 7/27/94

Operation Permit by: date

HEALTH DEPT. COPY: WHITE INSPECTION COPY (FINAL): GREEN OWNER COPY (FINAL): YELLOW INSPECTION COPY (INITIAL): PINK OWNER COPY (INITIAL): GOLD