IREDELL COUNTY HEALTH DEPARTMENT

Statesville Office (704) 878-5305 Mooresville Office (704) 660-3625 PERMIT # 180677

IMPROVEMENT PERMIT / AUTHORIZATION TO CONSTRUCT / OPERATION PERMIT / EXISTING SYSTEM

PIN # 4654580882

APPLICANT: Gerald & Barbara J Bodey APPLICANT ADDRESS: 13124 Ramah Church Rd

SITE ADDRESS: 127 Stone Haven Drive Mooresville NC 28115 PHONE: 704 8752890 ALT. PHONE: 704 779 7374


SITE DIRECTIONS: 77 South Exit 33 (L) Hwy 21 (R) Fairview (R) Hwy 115 (L) Perth Haven Rd (L) Stone Haven Lot on Left

SUBDIVISION: N/A SECTION: N/A LOT # N/A LOT AREA: 1.346 DESIGN FLOW: 360 L.T.A.R.: .35


Septic Tank	1000 (gal)	STB	Date	☒ New System	☐ Repair	☐ Expansion	System Type: I II (III) IV V VI	☒ Residence	No. Bedrooms	3	Water Supply
Pump Tank	(gal)	PT	Date	System Description:	GRAVITY 25% REDUCTION			☐ Business	No. Persons	2	☒ Private
Pump Make	Model		Serial #	Repair System Description:	SAME			☐ Other	No. Employees		☐ Public
# Nitrification Fields	1 # Lines	4	Linear Ft.	Maintenance Agreement Required:	☐ YES	☒ NO		☐ Slab	☒ Crawl Space		☐ Community
Trench Width	36"	☒ Trench Bottom Depth	MIN 36"	Gravel Depth	N/A	☒ GRAVITY	☐ PRESSURE	☐ Basement w/ plumbing		☐ Basement w/o plumbing	

Comments / Conditions: ① Maintain all setbacks and install lines on contour. ② Well for this home is located on adjacent property 100' ± to closest part of septic system. ③ SAPROLITE "SYSTEM" * All wells must be 100' away from initial and repair areas ④ House & system is shaded water ⑤ Pump, crush, & fill old tank on property * ⑥ Install DRAINLINES AT 36" minimum and maximum depth for better soils/LTA ⑦ NO OWNER REPAIRS FOUND ON SITE ⑧ NO Plumbing to BARN

INITIAL SITE SKETCH

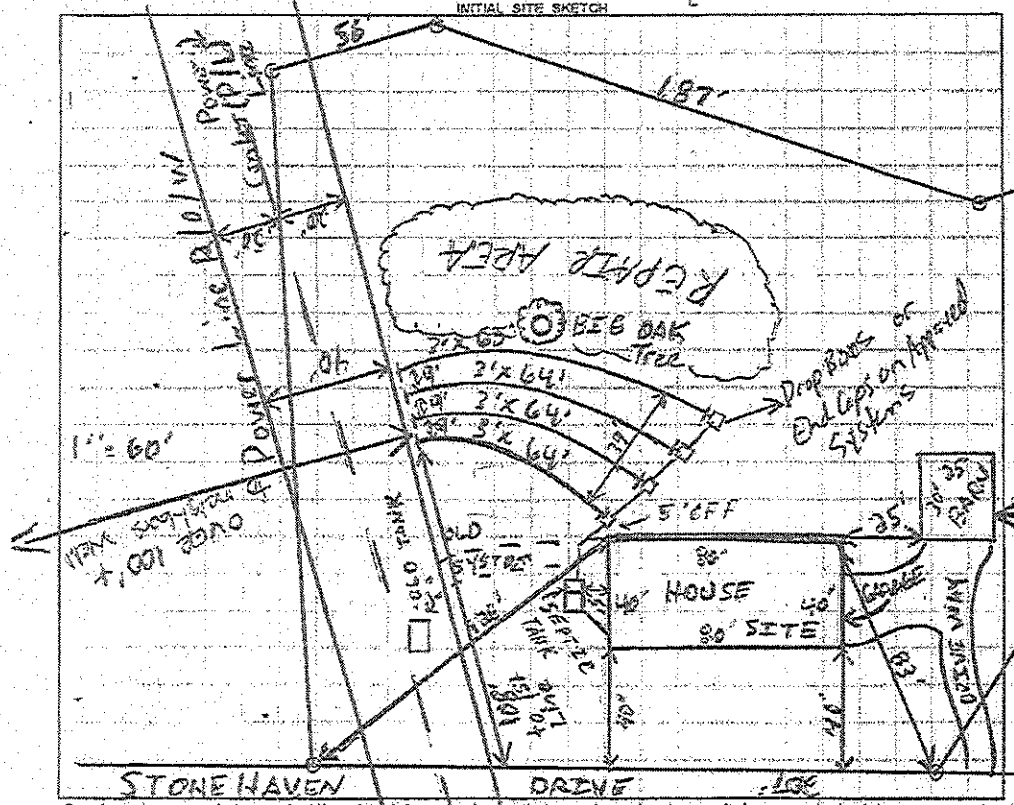

AS BUILT SKETCH

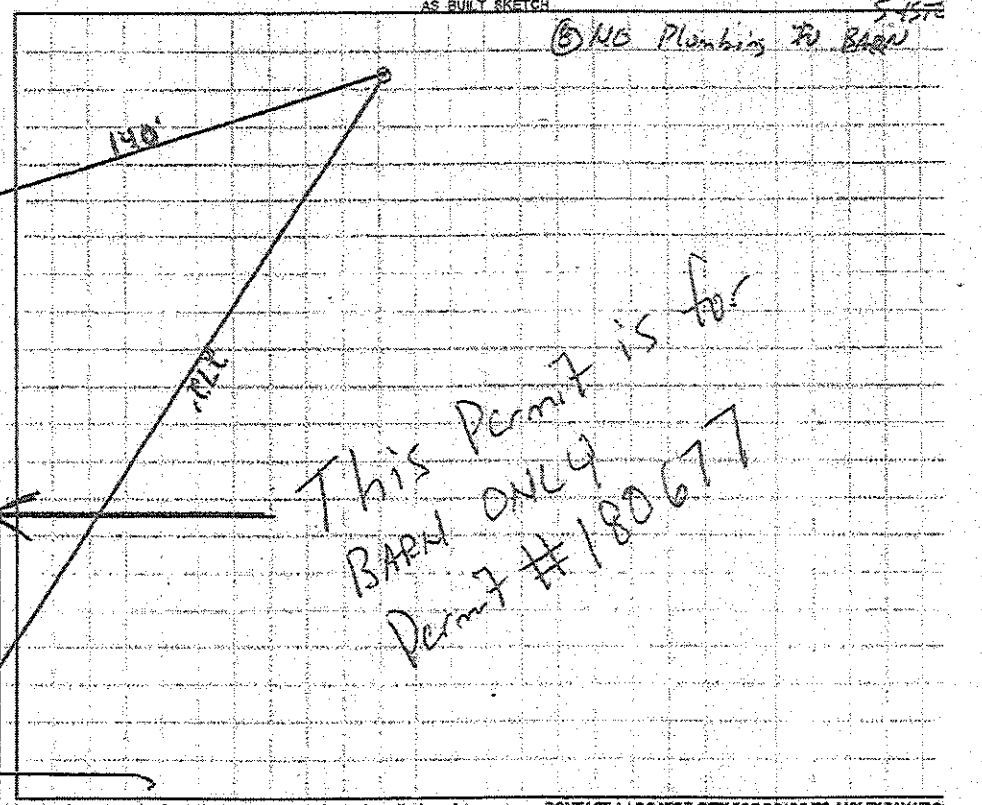

Permit can be suspended or revoked if any false information is supplied toward securing the permit / any unauthorized changes are made to the site / any unauthorized changes are made in the installation of the system. CONTACT A LOCATOR SERVICE PRIOR TO ANY EXCAVATIO

☐ IMPROVEMENT PERMIT *with plat valid without expiration.* ☒ IMPROVEMENT PERMIT *with site plan valid for 60 mos.* ☒ AUTHORIZATION TO CONSTRUCT *valid for period equal to IMPROVEMENT PERMIT--not to exceed 60 m*

Owner / Applicant Signature: B. J. Bodey Date: 10-8-13 Installed by:

IMPROVEMENT PERMIT by: Mark Betts Date: 10-7-13 OPERATION PERMIT by: Date:

AUTHORIZATION TO CONSTRUCT by: Mark Betts Date: 10-7-13 Existing System Inspected by: Date:

Health Dept. Copy - WHITE Applicant (Final Approval) - YELLOW Applicant (Conditional Approval) - PINK