IREDELL COUNTY HEALTH DEPARTMENT

Statesville Office (704) 878-5305 Mooresville Office (704) 660-3625 PERMIT # 178226 (was 180677)

IMPROVEMENT PERMIT / AUTHORIZATION TO CONSTRUCT / OPERATION PERMIT / EXISTING SYSTEM

PIN # 4654-58-0882.000

APPLICANT: Gerald + Brenda Boovy APPLICANT ADDRESS: 13124 Ramah Church Rd. Huntersville, NC 28078

SITE ADDRESS: 127 Stonehaven Dr. Mooresville, NC 28115 PHONE: 704-779-7374 ALT. PHONE: 704-875-2890


SITE DIRECTIONS: 77S, Exit 33, TL Hwy 21, TR Fairview, TR Hwy 115, TL Presbyterian, TL Stonehaven, site on L

SUBDIVISION: N/A SECTION: — LOT # — LOT AREA: 1.396 Acre DESIGN FLOW: 360 GPD. L.T.A.R.: .3

Septic Tank	1000 (gal)	STB	ZZ1	Date	11-11-15	☑ New System ☐ Repair ☐ Expansion	System Type: I II III IV V VI	☑ Residence	No. Bedrooms	3	Water Supply
Pump Tank	(gal)	PT		Date		System Description:	25% Reduction - Gravity	☐ Business	No. Persons	6	☑ Private
Pump Make		Model		Serial #		Repair System Description:	Same	☐ Other	No. Employees		☐ Public
# Nitrification Fields	1	# Lines	5	Linear Ft:	[redacted]	Maintenance Agreement Required:	☐ YES ☑ NO	☐ Slab	☑ Crawl Space		☐ Community
Trench Width	36"	Max. Trench Bottom Depth	36"	Gravel Depth	N/A		☑ GRAVITY ☐ PRESSURE	☐ Basement w/plumbing		☐ Basement w/o plumbing	

Comments / Conditions: Crush + Fill Existing Septic Tank. System in Saprolite. 100' Well Setback. Well to be used on this lot is located on adjacent property.

INITIAL SITE SKETCH

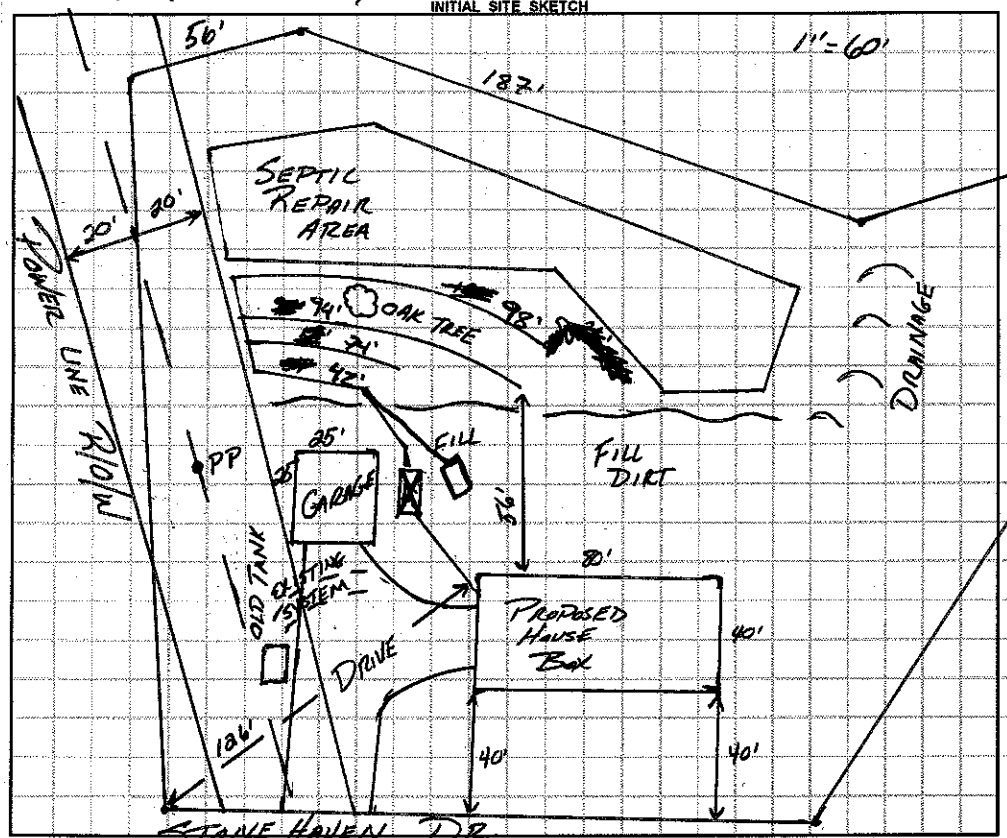

AS BUILT SKETCH

House appears to be slid back
Septic in correct spot

Permit can be suspended or revoked if any false information is supplied toward securing the permit / any unauthorized changes are made to the site / any unauthorized changes are made in the installation of the system. **CONTACT A LOCATOR SERVICE PRIOR TO ANY EXCAVATION**

☐ **IMPROVEMENT PERMIT** *with plat valid without expiration.* ☑ **IMPROVEMENT PERMIT** *with site plan valid for 60 mos.* ☑ **AUTHORIZATION TO CONSTRUCT** *valid for period equal to IMPROVEMENT PERMIT--not to exceed 60 mo.*

Owner / Applicant Signature: Brenda J. Boovy Date: 12-22-14 Installed by: Summey Septic

IMPROVEMENT PERMIT by: APPROVED Date: DEC 22 2014 OPERATION PERMIT by: APPROVED Date: JUN 08 2015

AUTHORIZATION TO CONSTRUCT by: APPROVED Date: DEC 22 2014 Existing System Inspected by: Date:

Health Dept. Copy - WHITE Applicant (Final Approval) - YELLOW Applicant (Conditional Approval) - PINK