/ Authorization To Construct   PIN# 4654-76-9652

IREDELL COUNTY HEALTH DEPARTMENT

STATESVILLE 704-878-5305   MOORESVILLE 704-664-5281

IMPROVEMENT PERMIT / ~~CERTIFICATE OF COMPLETION~~ / OPERATION PERMIT / EXISTING SYSTEM INSPECTION

PROPERTY DESCRIPTION NO. 25333   DATE 10/28/96   TAX MAP NO. 1C 7A 124   Watershed: ☐ Yes ☒ No

OWNER OR CONTRACTOR Ray Mozeley   PHONE: Business ______   Home 892-3747

ADDRESS 218 Canterbury Pl. Mooresville, NC. 28115

LOCATION Presbyterian Rd. TR Sink Farm on (R) just past Buckingham Place

SUBDIVISION Davidson Downs   BLOCK / SECTION II   LOT 124   LOT AREA .59 Ac   SITE CLASS. PS   DESIGN FLOW 360   L.T.A.R. .3

Septic Tank: 1000 Gallons; STB 794 Date 12/18/97
Pump Tank: ______ Gallons; PT ______ Date ______
Pump Make: ______ Model ______ Serial No. ______
Nitrification Field: No Fields 1   Square Feet 1200   Linear Feet 400
No Lines 4   Trench Width 36"   Max Trench Bottom Depth 36"   Gravel Depth 12"

☒ New System ☐ Repair   System Type: I, (II), III, IV, V, VI
System Description: DRP BX-CONV.
Repair System Description: SAME
Maintenance Agreement Required: ☐ Yes ☒ No

☒ House/Mod. Home   No. Bedrooms 3
☐ Mobile Home   No. Bathrooms 3
☐ Business   No. Employees ______
☐ Other ______


☐ Slab ☒ Crawl Space ☐ Basement w/plumbing ☐ Basement wo/plumbing

Water Supply:
☐ Individual
☒ Community
☐ Public

Comments:

Comments: Installed as drawn

INITIAL SITE SKETCH   **AS BUILT SKETCH**

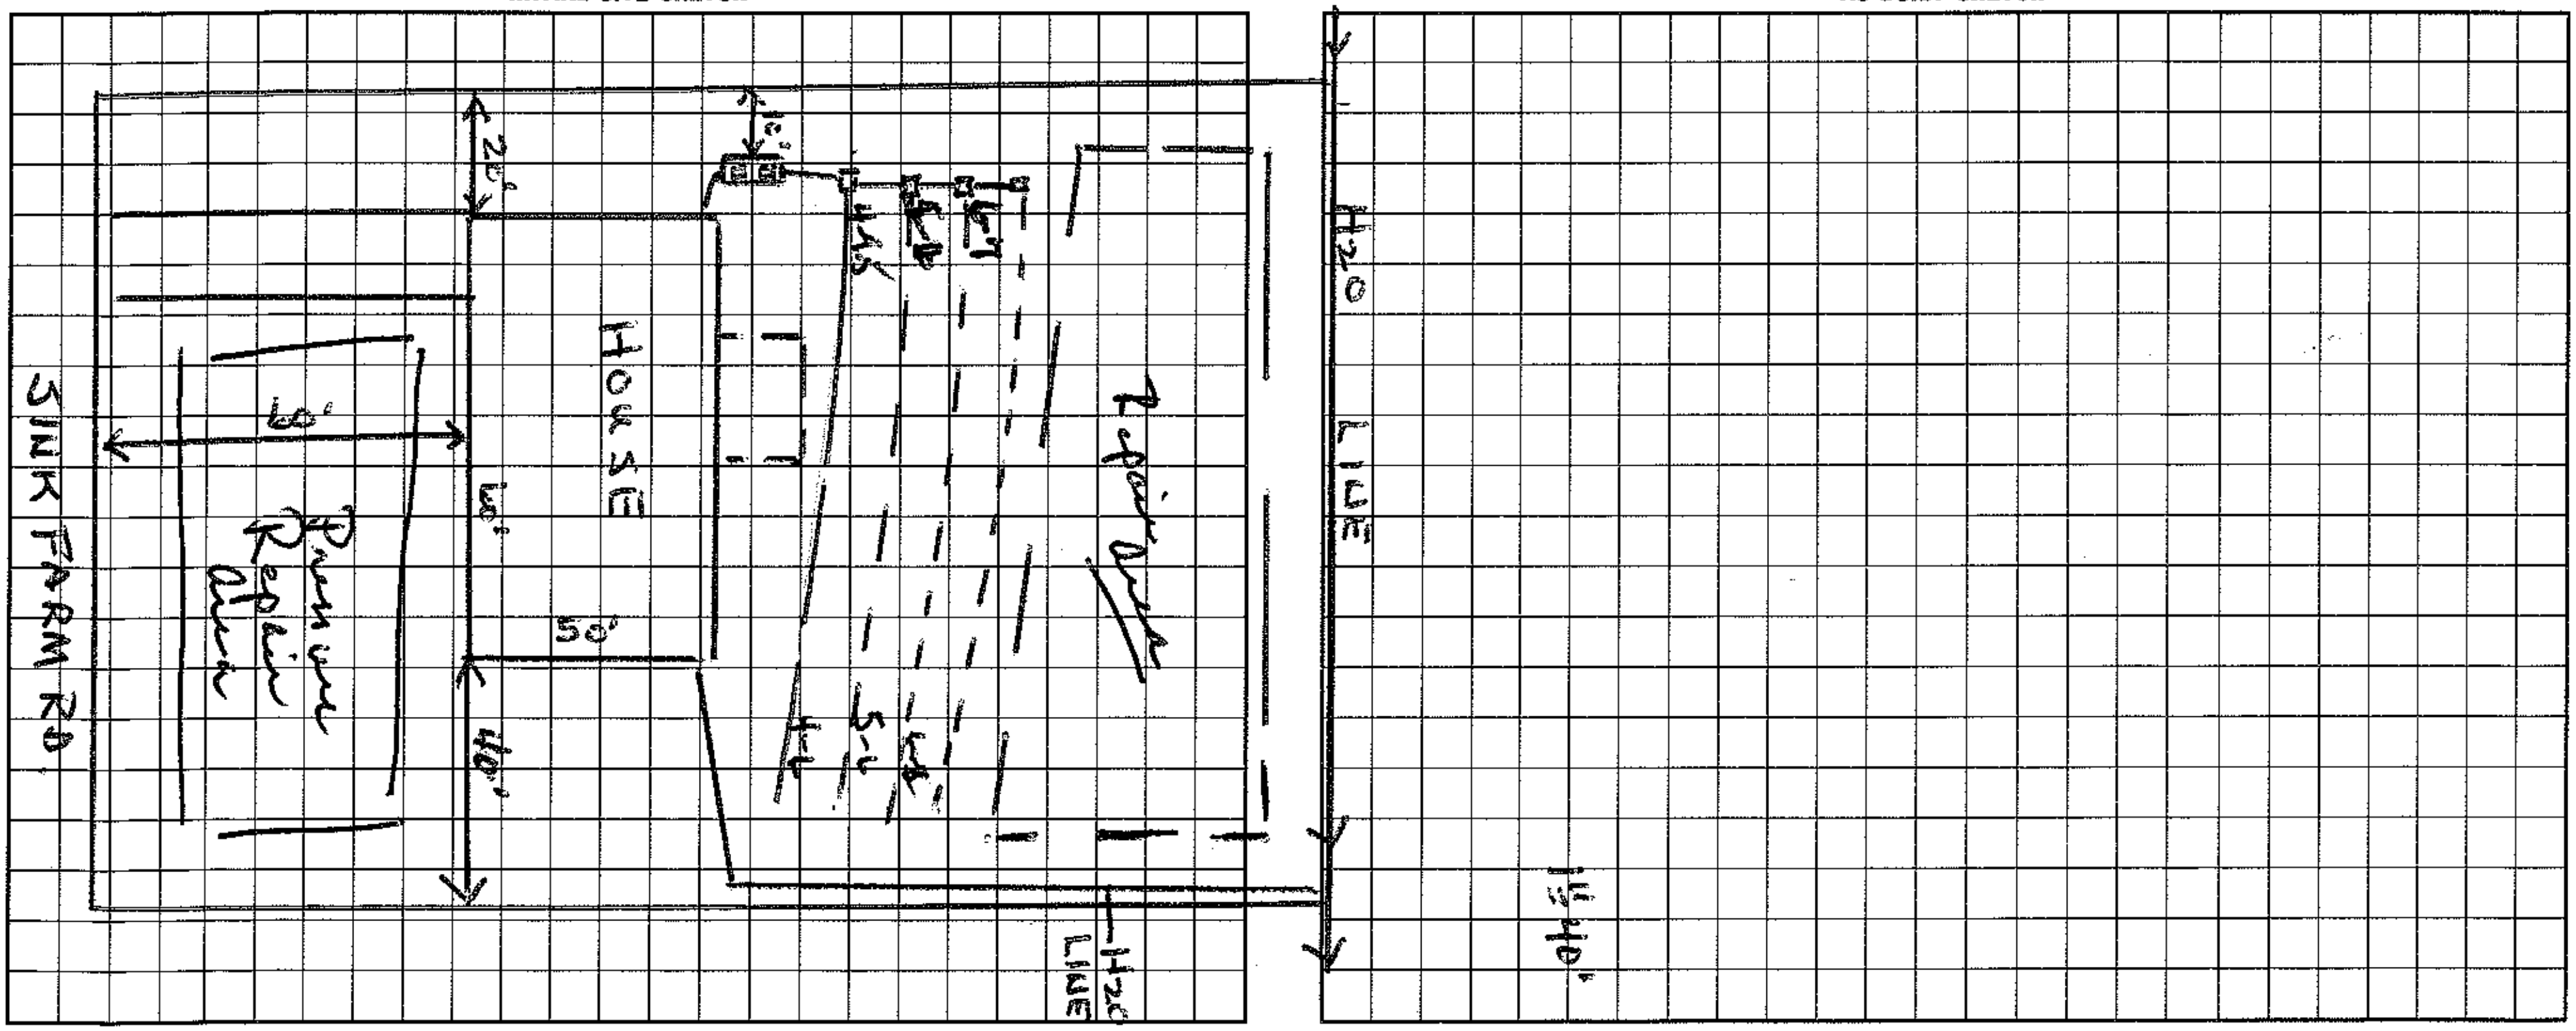

I understand that this permit can be suspended or revoked if any false information is supplied toward securing the permit/any unauthorized changes are made to the site/any unauthorized changes are made in the installation of the system.

Signed: * Ray Mozeley
Improvement Permit by: Wesley Sparks R.S.   date 10/28/96
Auth To Const ~~Existing System Inspection by:~~ Wesley Sparks R.S.   date 10/28/96

Installed by: Julian Bowles
Certificate of Completion by: Wesley Sparks R.S.   date 4/24/98
Operation Permit by: Wesley Sparks R.S.   date 4/24/98

HEALTH DEPT. COPY: WHITE   INSPECTION COPY (FINAL): GREEN   OWNER COPY (FINAL): YELLOW   INSPECTION COPY (INITIAL): PINK   OWNER COPY (INITIAL): GOLD