$130

IREDELL COUNTY HEALTH DEPARTMENT

STATESVILLE 704-878-5305 MOORESVILLE 704-664-5281

IMPROVEMENT PERMIT / AUTHORIZATION TO CONSTRUCT / OPERATION PERMIT / EXISTING SYSTEM INSPECTION

PERMIT# 115624 PIN# ~~4655866052~~ 4654-76-9652 DATE 2/2/04

OWNER OR CONTRACTOR LECHE Home Builders PHONE: Business 658-9786 Home

ADDRESS PO Box 1543 Mooresville NC 28115

LOCATION 115 (S) - TL PRESBYTERIAN - TR SINK FARM - ON RT EAST BUCKINGHAM

SUBDIVISION DAVIDSON DOWNS BLOCK / SECTION LOT 125 LOT AREA 1.51AC SITE CLASS PS DESIGN FLOW 480GPD L.T.A.R. .36PD/FT²

Septic Tank: 1000 Gallons; STB 312 Date 6/16/05

Pump Tank: Gallons; PT Date

Pump Make: Model Serial No.

Nitrification Field: No Fields 1 Square Feet 560 Linear Feet 280

No Lines 7@40' Trench Width 24" Max Trench Bottom Depth 36" Gravel Depth N/A

☒ New System ☐ Repair System Type: I, II, (III) IV, V, VI

System Description: GRAVITY PANEL

Repair System Description: LP PANEL

Maintenance Agreement Required: ☐ Yes ☒ No

☒ House/Mod. Home ☐ Mobile Home ☐ Business ☐ Other

No. Bedrooms 4 No. Bathrooms 4 No. Employees


☐ Slab ☒ Crawl Space ☐ Basement w/plumbing ☐ Basement wo/plumbing

Water Supply: ☐ Individual ☐ Public ☒ Community

Comments:/Conditions:

Comments:/Conditions:

INITIAL SITE SKETCH 1" = 50'

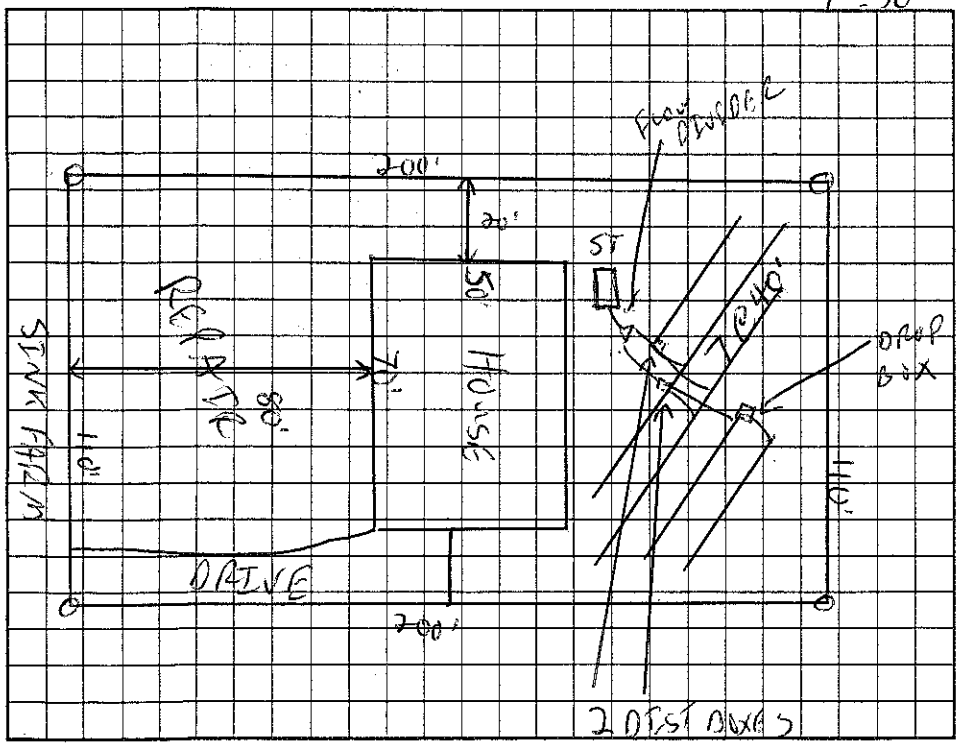

AS BUILT SKETCH

Permit can be suspended or revoked if any false information is supplied toward securing the permit/any unauthorized changes are made to the site/any unauthorized changes are made in the installation of the system. Improvement Permit with plat valid without expiration. Improvement Permit with site plan valid for sixty months. Authorization to Construct is valid for a period equal to that of Improvement Permit – not to exceed sixty months.

Signed: Scott Lee date 2/3/04

Improvement Permit by: C. G. Mayer RS date 2/2/04

Authorization to Construct by: RS date 3/12/04

Installed by: C. G. Mayer

Operation Permit by: RS date 6/17/05

Existing System Inspection by: date

HEALTH DEPT. COPY: WHITE OWNER COPY (FINAL): YELLOW OWNER COPY (INITIAL): PINK