IREDELL COUNTY HEALTH DEPARTMENT

STATESVILLE 704-878-5305 130.00 Paid MOORESVILLE 704-664-5281

IMPROVEMENT PERMIT / AUTHORIZATION TO CONSTRUCT / OPERATION PERMIT / EXISTING SYSTEM INSPECTION

PERMIT# 115627 PIN# 4654-77-2596 DATE 11/26/03

OWNER OR CONTRACTOR LECHE HOME BUILDERS PHONE: Business 658-9786 Home

ADDRESS PO BOX 1543 MOORESVILLE NC 28115

LOCATION 115(S) - TL PRESBYTERIAN - TR SINK FARM - ON RT

SUBDIVISION DAVIDSON DOWNS BLOCK / SECTION LOT 114 LOT AREA .47AC SITE CLASS. PS DESIGN FLOW 480GPD L.T.A.R. .36 PP/FR

Septic Tank: 1000 Gallons; STB 1017 Date 1/15/04
Pump Tank: Gallons; PT Date
Pump Make: Model Serial No.
Nitrification Field: No Fields 1 Square Feet 560 Linear Feet 280
No Lines 7@40' Trench Width 24" Max Trench Bottom Depth 36" Gravel Depth N/A

☒ New System ☐ Repair System Type: I, II, III, IV, V, VI
System Description: GRAVITY PANEL
Repair System Description: LP PANEL
Maintenance Agreement Required: ☐ Yes ☒ No

☒ House/Mod. Home No. Bedrooms 4
☐ Mobile Home No. Bathrooms 4
☐ Business No. Employees
☐ Other


☐ Slab ☒ Crawl Space ☐ Basement w/plumbing ☐ Basement wo/plumbing

Water Supply: ☐ Individual ☐ Public ☒ Community


Comments:/Conditions:

Comments:/Conditions:

INITIAL SITE SKETCH 1" = 50'

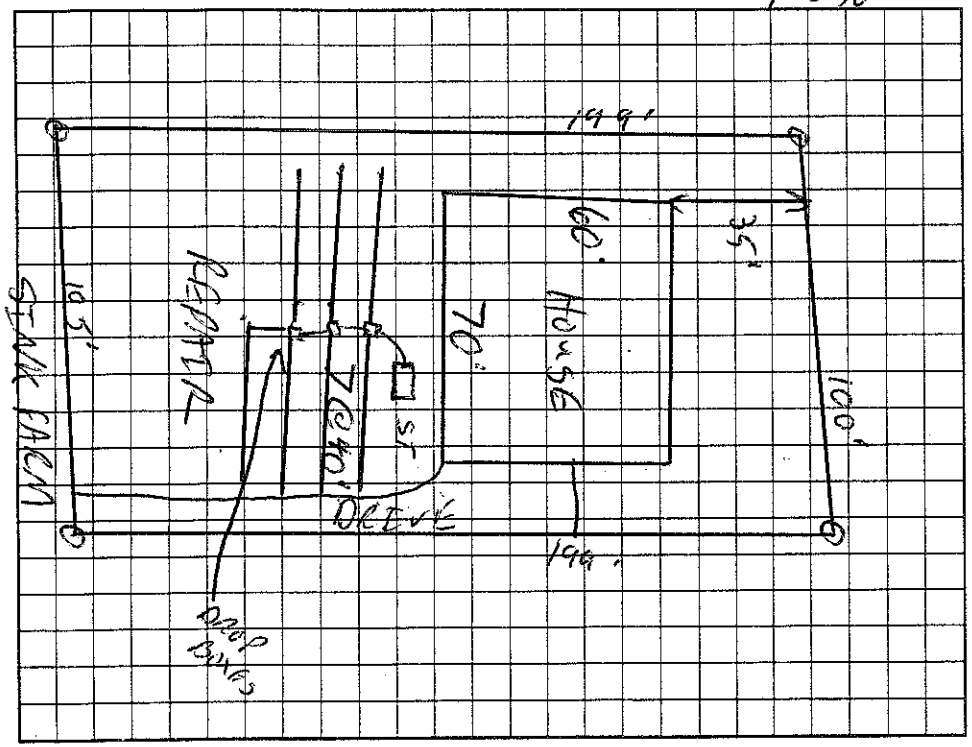

AS BUILT SKETCH

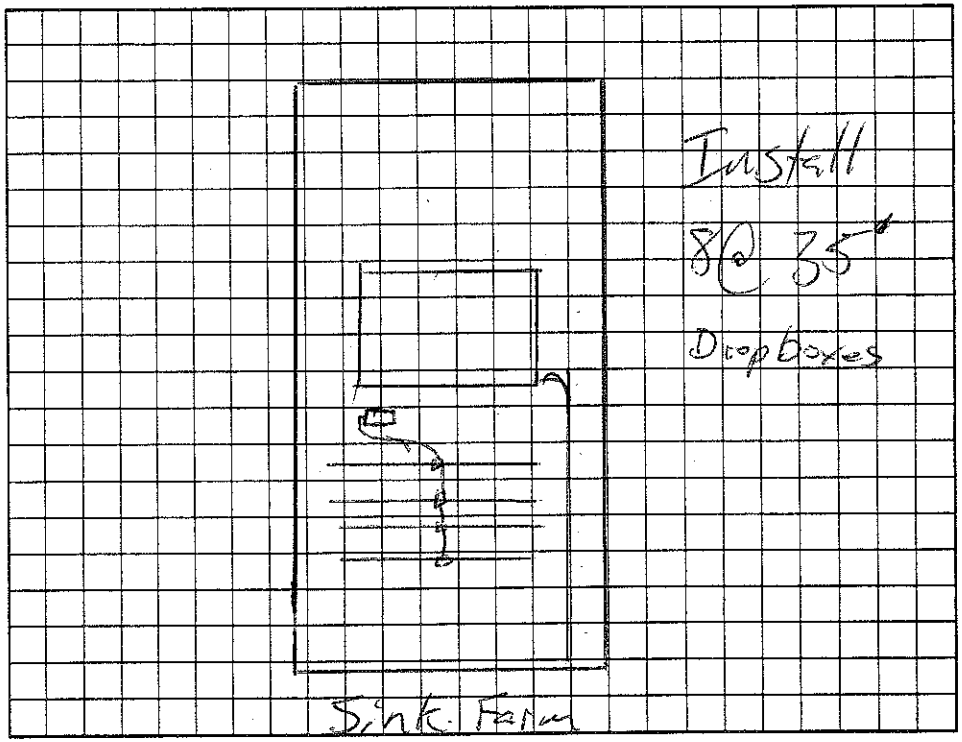

Permit can be suspended or revoked if any false information is supplied toward securing the permit/any unauthorized changes are made to the site/any unauthorized changes are made in the installation of the system. Improvement Permit with plat valid without expiration. Improvement Permit with site plan valid for sixty months. Authorization to Construct is valid for a period equal to that of Improvement Permit – not to exceed sixty months.

Signed: date 11/26/03 Installed by: A-1 Backhoe

Improvement Permit by: RS date 11/26/03 Operation Permit by: RS date 6/17/04

Authorization to Construct by: RS date 11/26/03 Existing System Inspection by: date

HEALTH DEPT. COPY: WHITE OWNER COPY (FINAL): YELLOW OWNER COPY (INITIAL): PINK