IREDELL COUNTY HEALTH DEPARTMENT

STATESVILLE 704-878-5305 MOORESVILLE 704-664-5281

IMPROVEMENT PERMIT / AUTHORIZATION TO CONSTRUCT / OPERATION PERMIT / EXISTING SYSTEM INSPECTION

PERMIT# 115626 PIN# 4654 77 2633 DATE 11/21/03

OWNER OR CONTRACTOR LECHE BUILDERS PHONE: Business 658-9786 Home

ADDRESS PO BOX 1943 MOORESVILLE.

LOCATION 115S - TL PRESBYTERIAN - TR SINK FARM - ON RT

SUBDIVISION DAVIDSON DOWNS BLOCK / SECTION 2 LOT 113 LOT AREA 1.46AC SITE CLASS PS DESIGN FLOW 480GPD L.T.A.R. .30PD/SQ FT

Septic Tank: 1000 Gallons; STB 10/2 Date 11/18/03
Pump Tank: Gallons; PT Date
Pump Make: Model Serial No.
Nitrification Field: No. Fields 1 Square Feet 560 Linear Feet 280
No Lines 7@40' Trench Width 24" Max Trench Bottom Depth 36" Gravel Depth N/A

☑ New System ☐ Repair System Type: I, II, III, IV, V, VI
System Description: GRAVITY PANEL
Repair System Description: LP PANEL
Maintenance Agreement Required: ☐ Yes ☑ No

☑ House/Mod. Home No. Bedrooms 4
☐ Mobile Home No. Bathrooms 4
☐ Business No. Employees
☐ Other


☐ Slab ☑ Crawl Space ☐ Basement w/plumbing ☐ Basement wo/plumbing

Water Supply: ☐ Individual ☐ Public ☑ Community


Comments/Conditions: DO NOT CUT HOUSE PAD

Comments/Conditions:

INITIAL SITE SKETCH 1"=50'

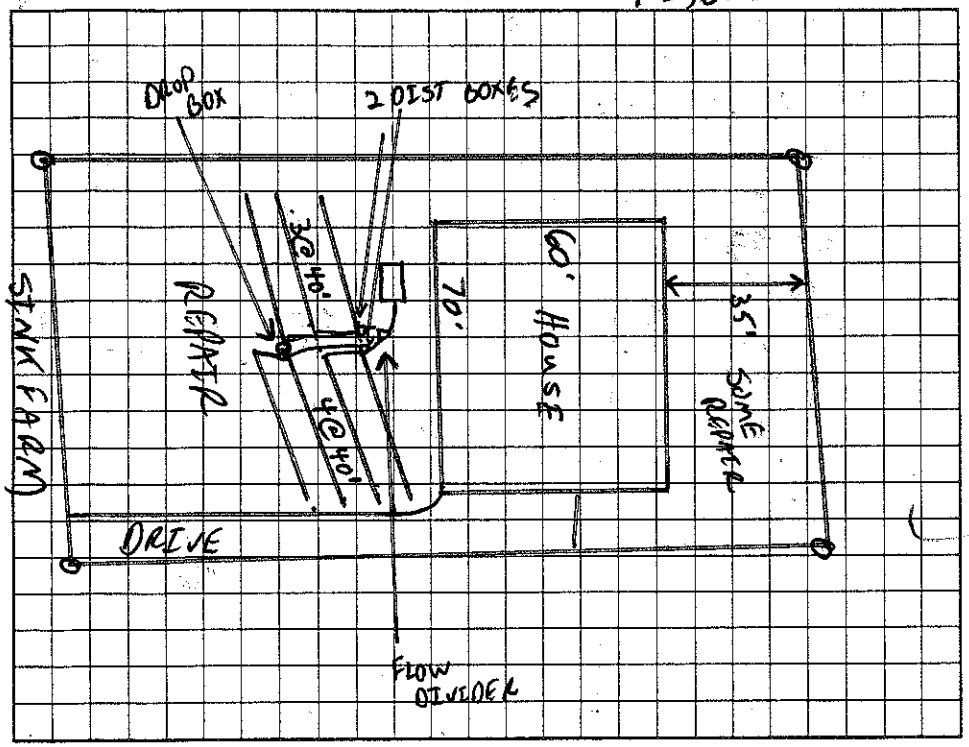

AS BUILT SKETCH

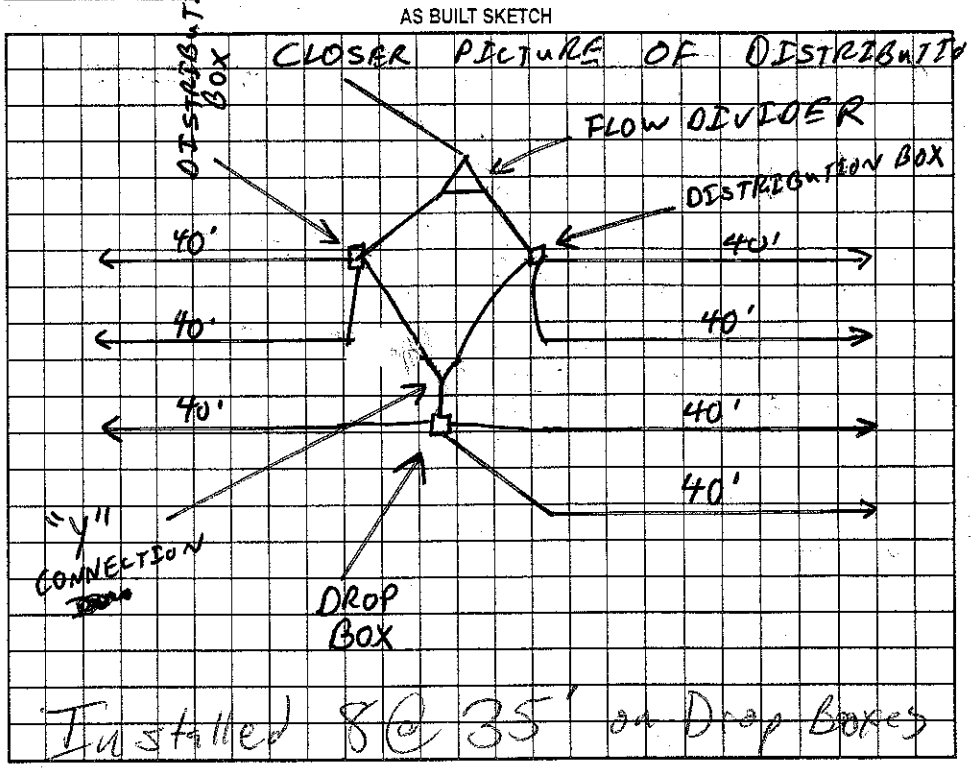

Permit can be suspended or revoked if any false information is supplied toward securing the permit/any unauthorized changes are made to the site/any unauthorized changes are made in the installation of the system. Improvement Permit with plat valid without expiration. Improvement Permit with site plan valid for sixty months. Authorization to Construct is valid for a period equal to that of Improvement Permit – not to exceed sixty months.

Signed: Scott Lee date 11/26/03

Improvement Permit by: C. Gaz RS date 11/21/03

Authorization to Construct by: C. Gaz RS date 11/21/03

Installed by: A-1 Backhoe

Operation Permit by: RS date 6/17/04

Existing System Inspection by: date

HEALTH DEPT. COPY: WHITE OWNER COPY (FINAL): YELLOW OWNER COPY (INITIAL): PINK