IREDELL COUNTY HEALTH DEPARTMENT

Statesville Office (704) 878-5305 Mooresville Office (704) 660-3625 PERMIT # 205076

IMPROVEMENT PERMIT / AUTHORIZATION TO CONSTRUCT / OPERATION PERMIT / EXISTING SYSTEM

PIN # 4165477346 8

APPLICANT: Kazimierz Zapadka APPLICANT ADDRESS: 132 Sink Farm Rd.

SITE ADDRESS: 130 Sink Farm Rd. PHONE: 704-997-6040 ALT. PHONE: N/A

SITE DIRECTIONS: Hwy 115 S TL Presbyterian TR Sink Farm Rd.

SUBDIVISION: Davidson Downes SECTION: 2 LOT # 115 LOT AREA: 0.47 acres DESIGN FLOW: 360 gpd L.T.A.R.: 0.3

Septic Tank 1000 (gal) STB 794 Date 3-17-15
Pump Tank (gal) PT Date
Pump Make Model Serial #
Nitrification Fields 1 # Lines 4 Linear Ft: 200'
Trench Width 24" Max. Trench Bottom Depth 36" Gravel Depth N/A


☑ New System ☐ Repair ☐ Expansion System Type: I II (III) IV V VI
System Description: PPBPS - GRAVITY
Repair System Description: Low Pressure PPBPS
Maintenance Agreement Required: ☐ YES ☑ NO
☑ GRAVITY ☐ PRESSURE

☑ Residence No. Bedrooms 3
☐ Business No. Persons 6
☐ Other No. Employees
☐ Slab ☑ Crawl Space
☐ Basement w/plumbing ☐ Basement w/o plumbing


Water Supply: ☐ Private ☐ Public ☑ Community

Comments / Conditions: Install a PPBPS on contour with parallel distribution, utilizing an effluent splitter such as Zoellar.
★ DO NOT CUT For House Pad or DRIVE ★

INITIAL SITE SKETCH

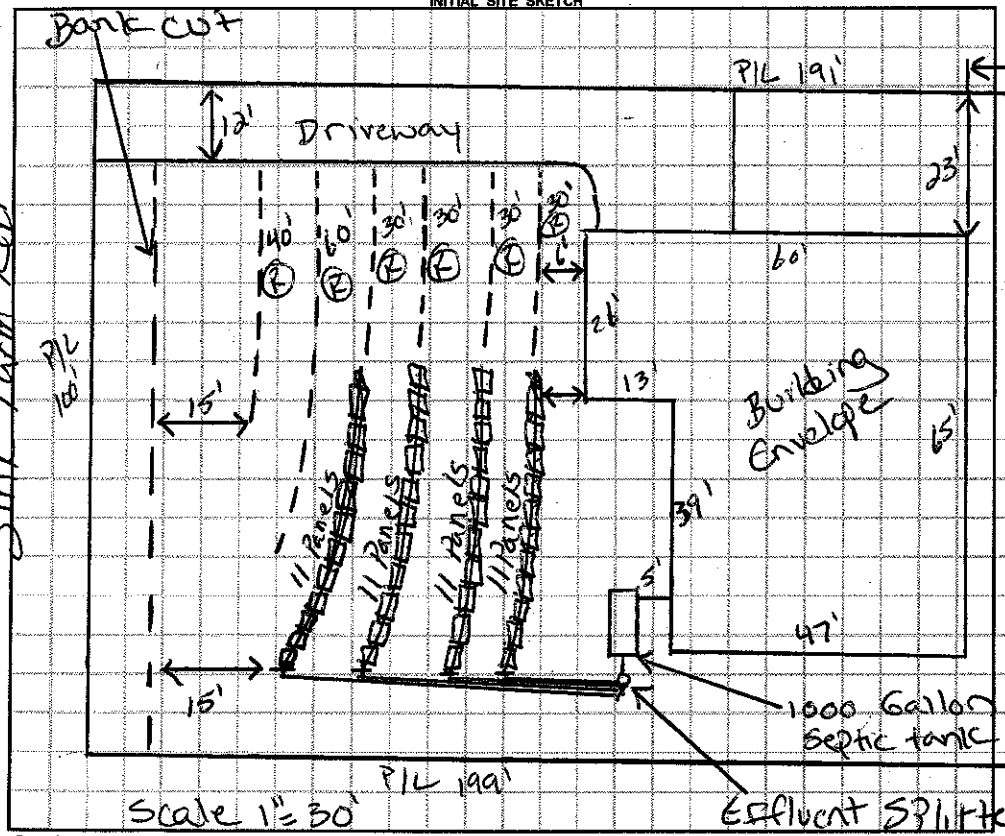

AS BUILT SKETCH

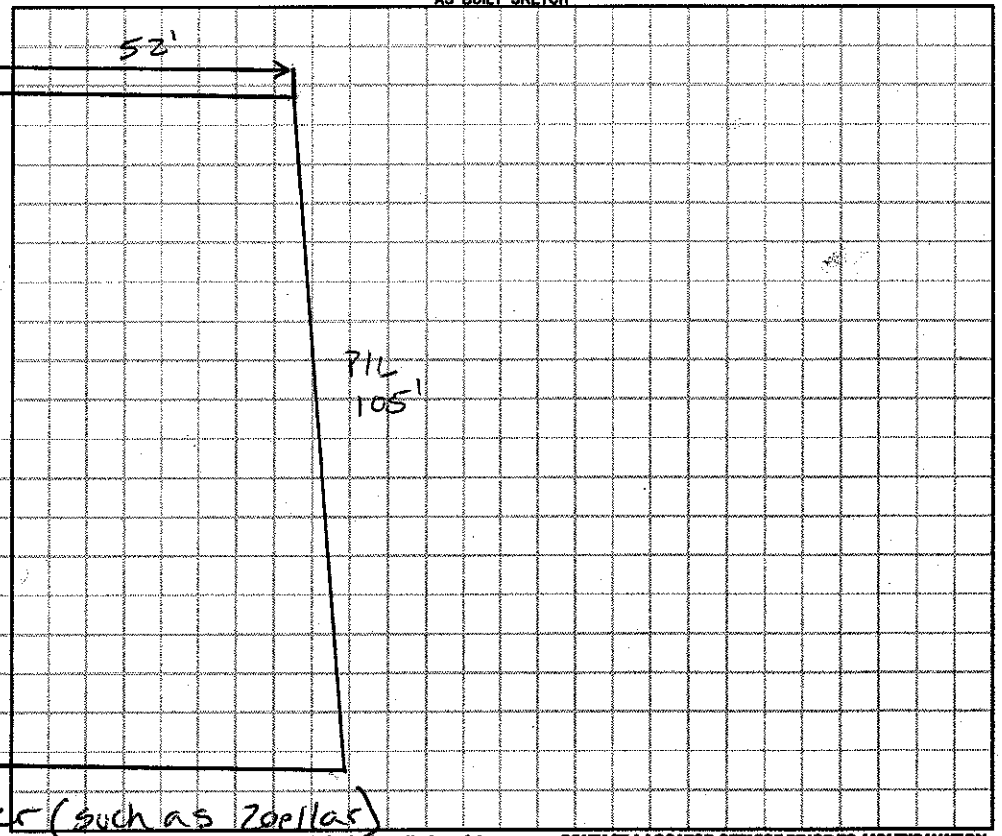

Permit can be suspended or revoked if any false information is supplied toward securing the permit / any unauthorized changes are made to the site / any unauthorized changes are made in the installation of the system. **CONTACT A LOCATOR SERVICE PRIOR TO ANY EXCAVATION**

☐ **IMPROVEMENT PERMIT** *with plat valid without expiration.* ☑ **IMPROVEMENT PERMIT** *with site plan valid for 60 mos.* ☐ **AUTHORIZATION TO CONSTRUCT** *valid for period equal to IMPROVEMENT PERMIT--not to exceed 60 mo.*

Owner / Applicant Signature: [signature] Date: 9-12-14 Installed by: Richard Abernathy

IMPROVEMENT PERMIT by: Justin Henderson Date: 9-12-14 OPERATION PERMIT by: [signature] Date: 4-24-15

AUTHORIZATION TO CONSTRUCT by: Justin Henderson Date: 9-12-14 Existing System Inspected by: Date:

Health Dept. Copy - WHITE Applicant (Final Approval) - YELLOW Applicant (Conditional Approval) - PINK