Paid $105.00 9-11-14
Ltd Relayout Bill
205076

E-MAILED
9-11-14

IREDELL COUNTY HEALTH DEPARTMENT
ENVIRONMENTAL HEALTH DIVISION
PAGE 1: *APPLICATION FORM*

Application For: Ltd Relayout ( ) New Well Permit ( ) Well Repair Permit ( ) Well Abandonment
(✓) Septic Improvement Permit ( ) Authorization to Construct ( ) Existing System Inspection ( ) Septic System Repair

THE ABOVE PERMIT DOCUMENTS WILL BECOME INVALID IF INFORMATION PROVIDED ON THIS APPLICATION IS FALSIFIED OR CHANGED, OR IF THE SITE IS ALTERED. THE IMPROVEMENT PERMIT IS VALID FOR EITHER 60 MONTHS OR WITHOUT EXPIRATION DEPENDING UPON DOCUMENTATION SUBMITTED APPLICATION WITH SITE PLAN 60 MONTHS, APPLICATION WITH COMPLETE, SCALED PLAT WITHOUT EXPIRATION. SEE 15A NCAC 18A .1937(f) FOR DETAILS.

Page 2: *Site Plan Worksheet* form MUST accompany this application

The following optional attachments may also be submitted: ( ) Survey Plat, scaled no more than 1 inch = 60 feet
Place an (X) beside whichever is submitted if applicable ( ) Custom Site Plan, scaled no more than 1 inch = 60 feet

Applicant Information:

Applicant Name: Kazimierz Zapadka Address: 132 Sink Farm Rd. Phone: 704-997-6040
" "

Owner Name: " Address: " Phone: "

Property Information:

Street Address: 130 Sink Farm Rd.

Subdivision Name: Davidson Downes Section/Phase: 2 Lot Number: 115

Driving Directions: Presbyterian to Sink Farm Rd. on Right

Site Development Information: *(check or complete ALL that apply)*

(✓) New Single Family Residence
( ) New Multi-Family Residence
( ) Accessory Building
( ) Bedroom(s) Addition

Maximum Number of Bedrooms: 3
Maximum Number of Occupants: 6
( ) Swimming Pool
( ) Other Addition/Structure: _____

(✓) Crawl Space Foundation
( ) Concrete Slab Foundation
( ) Basement with Plumbing
( ) Basement without Plumbing

Non-Residential Site Development:
Type of Business: _____
Square Footage of Building: _____
Maximum Number of Employee: _____
Maximum Number of Seats/Beds/Other: _____

Water Supply:

( ) New Well ( ) Existing Well (✓) Community Well ( ) City Water ( ) Other Public Water

Desired Septic System Type: *(you may rank in order of preference)* Year existing system installed: _____
(✓) No Preference ( ) Alternative ( ) Conventional ( ) Innovative ( ) Modified Conventional ( ) Other: _____

Please answer the following to the best of your ability:

( ) Yes (✓) No Does the site contain any jurisdictional wetlands?
( ) Yes (✓) No Is any non-domestic sewage (i.e. industrial) to be generated?
( ) Yes (✓) No Is the site subject to approval by any other public agency?

I have read this application and certify that the information provided herein is true, complete, and correct. Authorized county and state officials are granted right of entry to conduct necessary inspections to determine compliance with applicable laws and rules. I understand that I am solely responsible for the proper identification and labeling of all property lines and corners and making the site accessible so that a complete site evaluation can be performed.

Signature: _____ 9-11-14
Property owner or owner's legal representative signature (SIGNATURE REQUIRED) DATE

RECEIVED AUG - 5 2014 BN

Paid $500.00 Statesville

4654773468
.47 acres

IREDELL COUNTY HEALTH DEPARTMENT

2050716

ENVIRONMENTAL HEALTH DIVISION

PAGE 1: *APPLICATION FORM*

Application For: ( ) New Well Permit (X) Well Repair Permit ( ) Well Abandonment
( ) Septic Improvement Permit ( ) Authorization to Construct ( ) Existing System Inspection ( ) Septic System Repair

THE ABOVE PERMIT DOCUMENTS WILL BECOME INVALID IF INFORMATION PROVIDED ON THIS APPLICATION IS FALSIFIED OR CHANGED, OR IF THE SITE IS ALTERED. THE IMPROVEMENT PERMIT IS VALID FOR EITHER 60 MONTHS OR WITHOUT EXPIRATION DEPENDING UPON DOCUMENTATION SUBMITTED APPLICATION WITH SITE PLAN 60 MONTHS, APPLICATION WITH COMPLETE, SCALED PLAT WITHOUT EXPIRATION. SEE 15A NCAC 18A .1937(f) FOR DETAILS.

Page 2: *Site Plan Worksheet* **form MUST accompany this application**

The following optional attachments may also be submitted: ( ) Survey Plat, scaled no more than 1 inch = 60 feet
Place an (X) beside whichever is submitted if applicable ( ) Custom Site Plan, scaled no more than 1 inch = 60 feet

Applicant Information:

Applicant Name: K.M. Zapadka Address: 132 Sink Farm Rd Mooresville Phone: 704 997-6040

Owner Name: K.M. Zapadka Address: 132 Sink Farm Rd Phone: 704 997-6040

Property Information:

Street Address: Lot #115 130 Sink Farm Rd (on Right)

Subdivision Name: Davidson Downes Section/Phase: _____ Lot Number: 115

Driving Directions: Presbyterian to Sink Farm on Rt

Site Development Information: *(check or complete ALL that apply)*

(X) New Single Family Residence
( ) New Multi-Family Residence
( ) Accessory Building
( ) Bedroom(s) Addition

Maximum Number of Bedrooms: 3
Maximum Number of Occupants: 2
( ) Swimming Pool NO
( ) Other Addition/Structure: NO

(X) Crawl Space Foundation
( ) Concrete Slab Foundation
( ) Basement with Plumbing
( ) Basement without Plumbing

Non-Residential Site Development:

Type of Business: _____
Square Footage of Building: 2285
Maximum Number of Employee: _____
Maximum Number of Seats/Beds/Other: _____

Water Supply:

( ) New Well ( ) Existing Well (X) Community Well ( ) City Water ( ) Other Public Water

Desired Septic System Type: *(you may rank in order of preference)* Year existing system installed: _____

(X) No Preference ( ) Alternative ( ) Conventional ( ) Innovative ( ) Modified Conventional ( ) Other: _____

Please answer the following to the best of your ability:

( ) Yes (X) No Does the site contain any jurisdictional wetlands?
( ) Yes (X) No Is any non-domestic sewage (i.e. industrial) to be generated?
( ) Yes (X) No Is the site subject to approval by any other public agency?

I have read this application and certify that the information provided herein is true, complete, and correct. Authorized county and state officials are granted right of entry to conduct necessary inspections to determine compliance with applicable laws and rules. I understand that I am solely responsible for the proper identification and labeling of all property lines and corners and making the site accessible so that a complete site evaluation can be performed.

Signature: _____ 8-5-14
Property owner or owner's legal representative signature (SIGNATURE REQUIRED) DATE

PAID
120

IREDELL COUNTY HEALTH DEPARTMENT


ENVIRONMENTAL HEALTH DIVISION

PAGE 2: *SITE PLAN WORKSHEET*

SEE THE "SAMPLE SITE PLAN" BELOW. *INCOMPLETE SITE PLANS WILL BE RETURNED TO YOU FOR COMPLETION AND MAY RESULT IN A DELAY IN THE ISSUANCE OF YOUR SEPTIC SYSTEM PERMIT!!!*

Place an (X) beside each item as you complete the site plan:

- ( ) Property Line measurements are clearly identified
- ( ) All proposed structures are indicated
- ( ) Front and side setbacks from property line
- ( ) Preferred driveway location and well location
- ( ) Area you prefer your septic system to be placed
- ( ) North arrow, or other sufficient indicator of direction

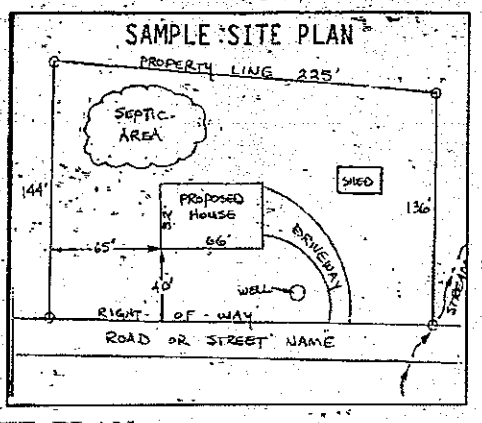


Circle N/A on the following if appropriate:

Location of septic systems and wells within 100' of your property	N/A
Location of easements and rights of ways on your property	N/A
Location of any designated wetlands on the property	N/A

USE THIS SPACE TO DRAW YOUR SITE PLAN

Show: proposed house or business footprint, wells, water lines, patios, pools and decks, and any other item that will occupy space on the site

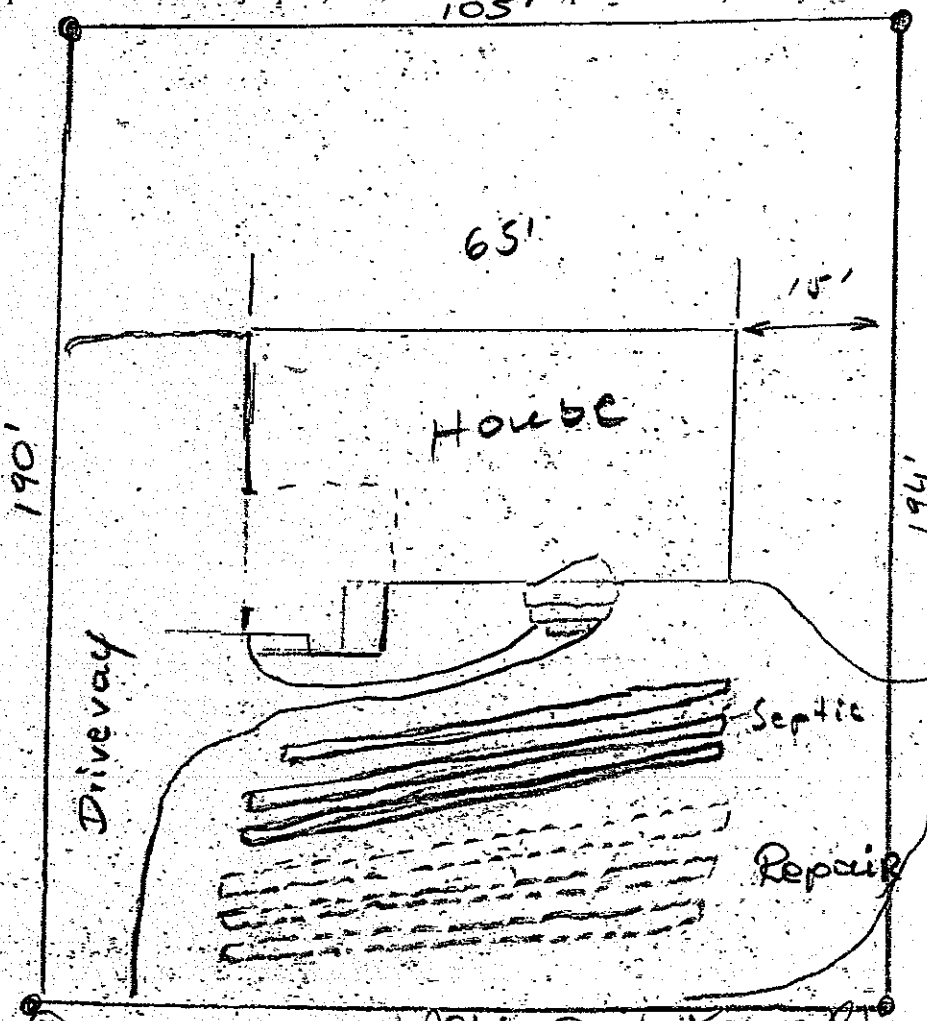

Signature: _____ 8-5-14

Property owner or owner's legal representative signature (SIGNATURE REQUIRED) — DATE

From; KM Zapadka

132 Sink Farm Rd.

Mooresville NC 28115

Kzapadka117@yahoo.com

704 425 7509

Request to change Septic Plan

Please note: Wrong data was given to Health Department Agent by me Mr. Zapadka.

Actual width of driveway from the road to the house garage wall will be max. 12 ft. wide and not 23 ft. as can be found in original Septic Permit.. The driveway width needs to stay within max.12 ft. in width.

Simply, I need to move leaching line away from the house and possibly make only three lines instead there is four lines now. Reason: make more room for walkway and greenery in front of the house, at this original design room for walkway and flowers/greenery is very limited.

Please be advice that We have extra field/room taken from driveway to obtain for Septic and that is 13 ft. long way from the street to the house.

Thank You for Your time and understanding.

Very Truly Kazimierz Zapadka

9/10/14

IREDELL COUNTY HEALTH DEPARTMENT

Statesville Office (704) 878-5305 Mooresville Office (704) 660-3625 PERMIT # 205076

IMPROVEMENT PERMIT / AUTHORIZATION TO CONSTRUCT / OPERATION PERMIT / EXISTING SYSTEM

PIN # 4654773468

APPLICANT: Kazimiesz Zapadka APPLICANT ADDRESS: 132 Sink Farm Rd.

SITE ADDRESS: 130 Sink Farm Rd PHONE: 704-997-6040 ALT. PHONE: N/A


SITE DIRECTIONS: I-55 TL Presbyterian TR Sink Farm Rd.

SUBDIVISION: Davidson Downes SECTION: 2 LOT # 115 LOT AREA: 0.47 acres DESIGN FLOW: 360 gpd L.T.A.R.: 0.3


Septic Tank	1000	(gal)	STB		Date		☑ New System	☐ Repair	☐ Expansion	System Type: I II III IV V VI		☑ Residence	No. Bedrooms	3	Water Supply				
Pump Tank		(gal)	PT		Date		System Description:			PPBPS - GRAVITY		☐ Business	No. Persons	6	☐ Private				
Pump Make			Model		Serial #		Repair System Description:			Low Pressure PPBPS		☐ Other	No. Employees		☐ Public				
# Nitrification Fields	1		# Lines	4	Linear Ft:	200	Maintenance Agreement Required:		☐ YES	☑ NO		☐ Slab	☑ Crawl Space		☑ Community				
Trench Width	24"		Max. Trench Bottom Depth	36"	Gravel Depth	N/A	☑ GRAVITY		☐ PRESSURE			☐ Basement w/plumbing			☐ Basement w/o plumbing				

Comments / Conditions: Install a PPBPS system on contour with parallel distribution, utilizing an effluent splitter such as Zoellar.
Do NOT CUT FOR Driveway or House Pad

INITIAL SITE SKETCH

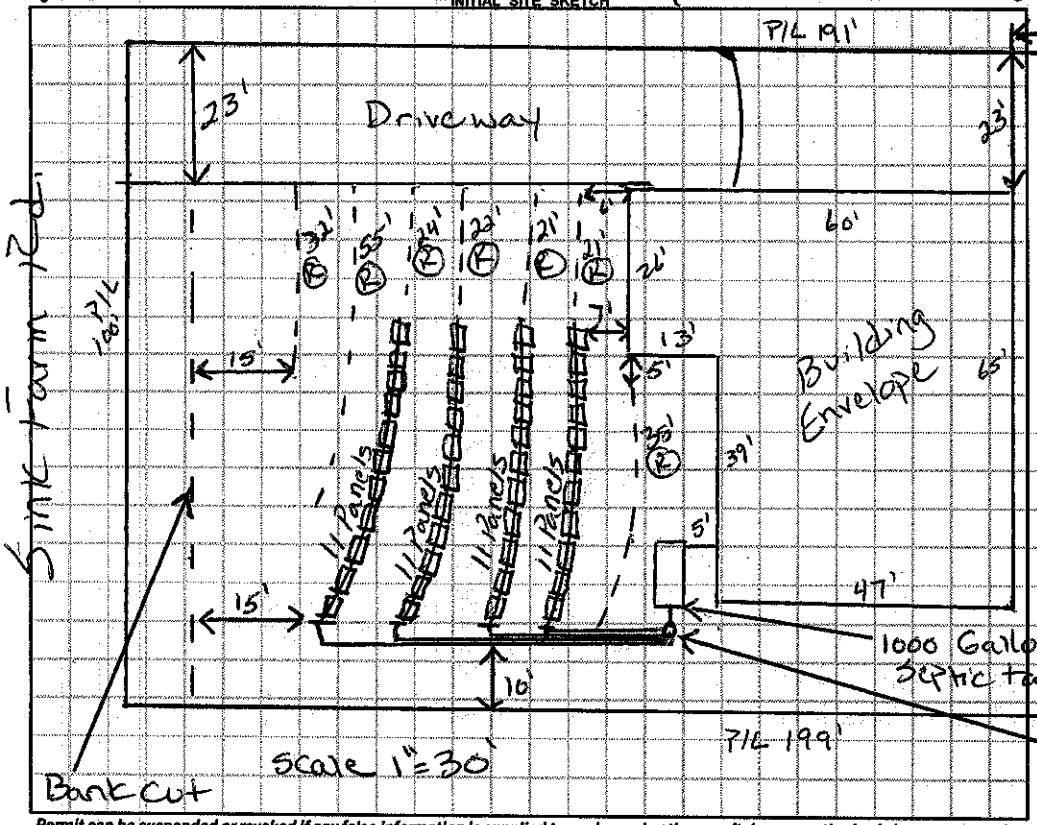

AS BUILT SKETCH

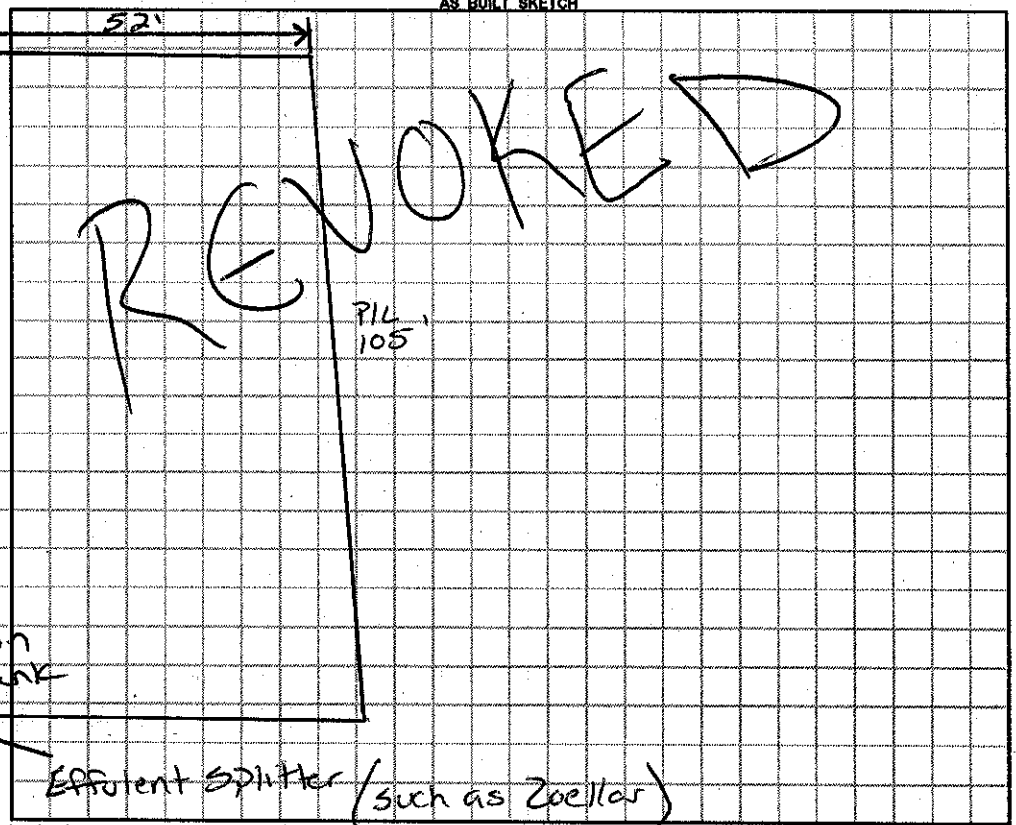

Permit can be suspended or revoked if any false information is supplied toward securing the permit / any unauthorized changes are made to the site / any unauthorized changes are made in the installation of the system. **CONTACT A LOCATOR SERVICE PRIOR TO ANY EXCAVATION**

☐ **IMPROVEMENT PERMIT** *with plat valid without expiration.* ☑ **IMPROVEMENT PERMIT** *with site plan valid for 60 mos.* ☑ **AUTHORIZATION TO CONSTRUCT** *valid for period equal to IMPROVEMENT PERMIT--not to exceed 60 mo.*

Owner / Applicant Signature: [signature] Date: 9-9-14 Installed by:

IMPROVEMENT PERMIT by: Justin Henderson Date: 9-6-14 OPERATION PERMIT by: Date:

AUTHORIZATION TO CONSTRUCT by: Justin Henderson Date: 9-6-14 Existing System Inspected by: Date:


Health Dept. Copy - WHITE Applicant (Final Approval) - YELLOW Applicant (Conditional Approval) - PINK


DAS
DON ALLEN & ASSOCIATES, P.A.
"Since 1971"
Commercial * Residential * Mortgage Surveys * Multi-Family
Construction Staking * Subdivision Design * Topographical
111-B Raceway Drive * Mooresville * NC * 28117
(704) 664-7029 (704) 664-8041 Fax

I, certify that this map was drawn under my supervision from an actual survey made under my supervision recorded in deed book 2073, page 523, and/or plat book 19, page 49, that the ratio of precision is 1':10,000, that this map was prepared in accordance with the General Statutes of North Carolina Chapter 89C. my hand and seal on the 6, day of AUG., A.D. 20 14.

WILLIAM M. ALLEN, PLS

LINE TABLE		
LINE	BEARING	LENGTH
L1	N 40°44'33" W	5.23'

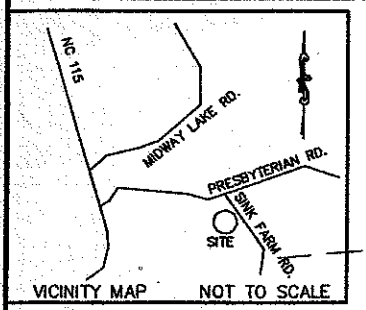


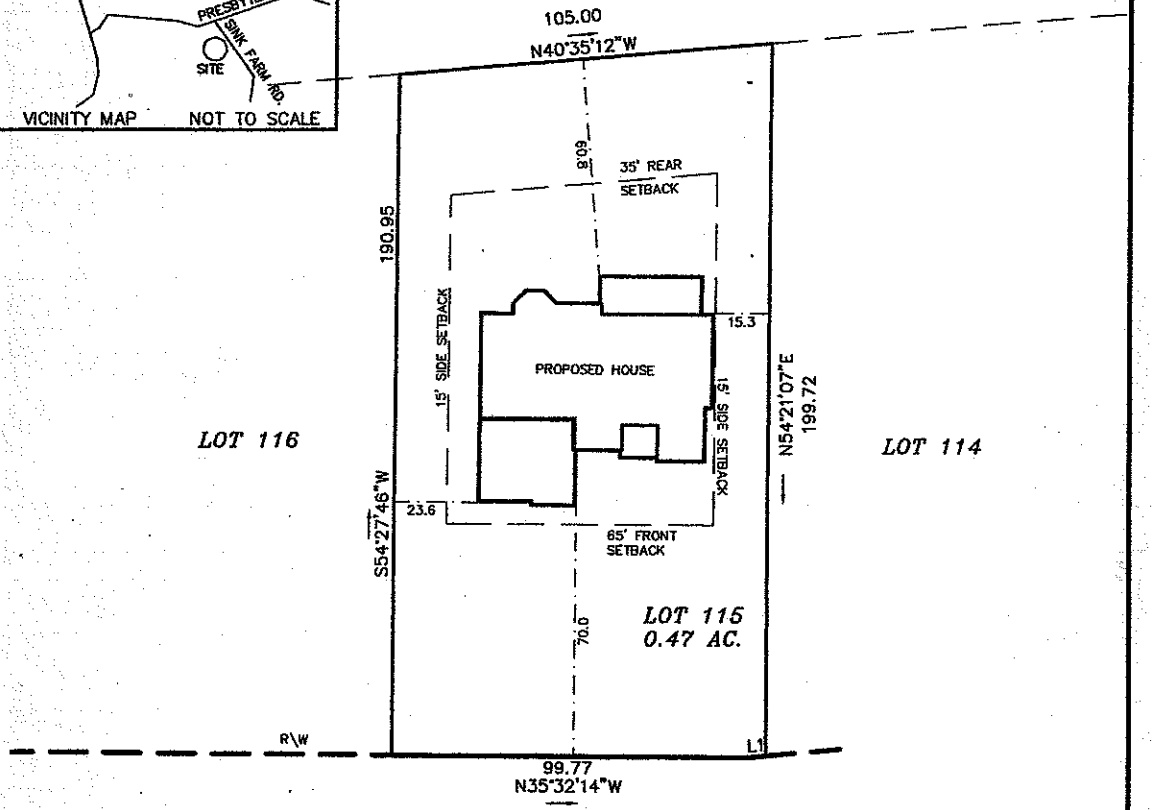

SINK FARM RD.
(60' PUBLIC R\W)

R\W

NOTES
1) THIS PROPERTY MAY BE SUBJECT TO ANY EASEMENTS AND/OR RIGHTS OF WAY OF RECORD.
2) ACREAGE COMPUTED BY THE COORDINATE METHOD.
3) UNDERGROUND POWER
4) NO GRID MONUMENT FOUND WITHIN 2000 FEET.

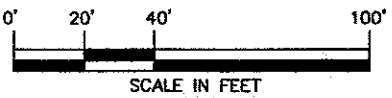

LEGEND
E.I.P. = #4 REBAR FOUND
I.P.S. = #4 REBAR SET
R/W = RIGHT-OF-WAY

PLOT PLAN SURVEY

OF

LOT 115 DAVIDSON DOWNES SECT. 2

SCALE 1" = 40'

CODDLE CREEK TWSP., IREDELL CO., N.C.

ACQUIRED BY: KAZIMIERZ ZAPADKA

FIELD BOOK:
FILE: DAVIDSON DOWNES 115
DC FILE: