IREDELL COUNTY HEALTH DEPARTMENT

STATESVILLE 704-878-5305 MOORESVILLE 704-664-5281

IMPROVEMENT PERMIT / AUTHORIZATION TO CONSTRUCT / OPERATION PERMIT / EXISTING SYSTEM INSPECTION

2100

PERMIT# 138873 PIN# ~~4654 17 3991 000~~ 4654-17-3952 DATE 11/8/06

OWNER OR APPLICANT DAVIDSON DOWNES INC PHONE: Business 980 297 2787 Home

ADDRESS 4643 MARINER LN. DENVER, NC 28037

LOCATION 115 S TL PRESBYTERIAN RD TR SINK FARM, 2ND LOT ON (L)

SUBDIVISION DAVIDSON DOWNES BLOCK / SECTION 2 LOT 50 LOT AREA .499 SITE CLASS. PS DESIGN FLOW 480 L.T.A.R. .3

Septic Tank: 1000 Gallons; STB 794 Date 4/4/07
Pump Tank: Gallons; PT Date
Pump Make: Model Serial No.
Nitrification Field: No Fields 1 Square Feet 1260 Linear Feet 420
No Lines 7@60' Trench Width 3' Max Trench Bottom Depth 3" Gravel Depth NA

☒ New System ☐ Repair ☐ Expansion System Type: I II (III) IV V VI
System Description: GRAV - 250 gal REDUCED
Repair System Description: PRES - 16" PAPAS
Maintenance Agreement Required: ☐ Yes ☒ No

☒ House/Mod. Home No. Bedrooms 4
☐ Mobile Home No. Persons
☐ Business No. Employees
☐ Other

Water Supply: ☐ Individual ☐ Public ☒ Community


☐ Gravity ☐ Pressure ☐ Slab ☒ Crawl Space ☐ Basement w/plumbing ☐ Basement wo/plumbing

Comments:/Conditions: LINES INSTALLED ON CONTOUR
MUST MAINTAIN 10' FROM ALL PROPERTY LINES


Comments:/Conditions: IQ4W - INSTALLED

1" = 50'

INITIAL SITE SKETCH

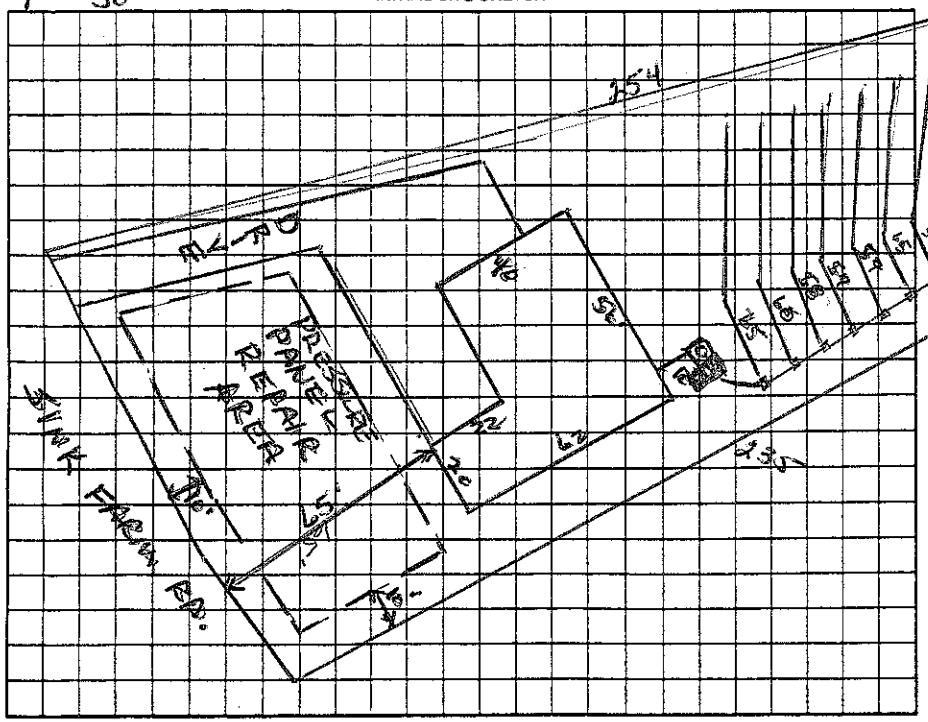

AS BUILT SKETCH

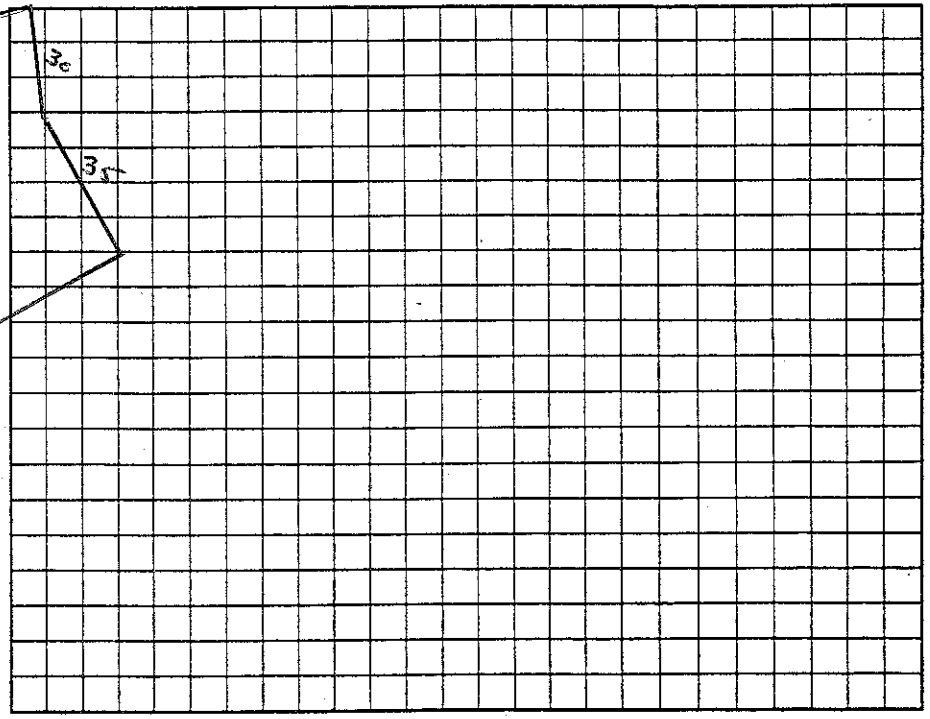

Permit can be suspended or revoked if any false information is supplied toward securing the permit/any unauthorized changes are made to the site/any unauthorized changes are made in the installation of the system. Improvement Permit with plat valid without expiration ☐ Improvement Permit with site plan valid for sixty months ☐ Authorization to Construct is valid for a period equal to that of Improvement Permit -- not to exceed sixty months.

Signed: [signature] date 12-8-06 Installed by: Larry Hankle

Improvement Permit by: Wesley Sparks R.S. date 11/8/06 Operation Permit by: Wesley Sparks R.S. date 5/16/07

Authorization to Construct by: Wesley Sparks R.S. date 11/8/06 Existing System Inspection by: date

HEALTH DEPT. COPY: WHITE OWNER COPY (FINAL): YELLOW OWNER COPY (INITIAL): PINK