IREDELL COUNTY HEALTH DEPARTMENT

ATESVILLE 704-878-5305 MOORESVILLE 704-664-5281

IMPROVEMENT PERMIT / AUTHORIZATION TO CONSTRUCT / OPERATION PERMIT / EXISTING SYSTEM INSPECTION

PERMIT # 158493 PIN # 4654774329 DATE 10-5-09

OWNER or APPLICANT Kazimerz & Marianna Zapadka PHONE: Business 704 608-3623 Casey Home 704 799-4437

OWNER or APPLICANT ADDRESS 316 E. Waterlynn Rd Mooresville, NC. 28115

LOCATION / DIRECTIONS Hwy 115 South TL Presbyterian TR Sink Farm Rd on right

SUBDIVISION Davidson Downs BLOCK / SECTION C LOT # 116 LOT AREA .45Ac. DESIGN FLOW 480gpd L.T.A.R. .25 gpd

Septic Tank 1500 1000 Gallons: STB 338 Date 5-11-10

Pump Tank Gallons: PT Date

Pump Make Model Serial #

Nitrification Field No Fields 1 No Lines 6 Linear Feet 480 ft.

Trench Width 1&2@ 80' Max. Trench Bottom Depth 36" Gravel Depth N/A

☒ New System ☐ Repair ☐ Expansion System Type I II III IV V VI

System Description: Gravity - 25% Reduction

Repair System Description: Pump-LP - 50% Reduction

Maintenance Agreement Required ☐ YES ☒ NO Not initially

☒ GRAVITY ☐ PRESSURE


☒ Residence No. Bedrooms 4 ☐ Business No. Persons ☐ Other No. Employees ☐ Slab ☒ Crawl Space ☐ Basement w/plumbing ☐ Basement w/o plumbing

Water Supply: ☐ Private ☐ Public ☒ Community

Comments / Conditions: Note: Must hug property line with Driveway (as shown) Keep Septic System at least 10ft from PL; keep Supply line at least 5ft from PL


Comments / Conditions: *Leave room by ST for future Pump tank Installed ADS 36" Plastic Chambers

INITIAL SITE SKETCH

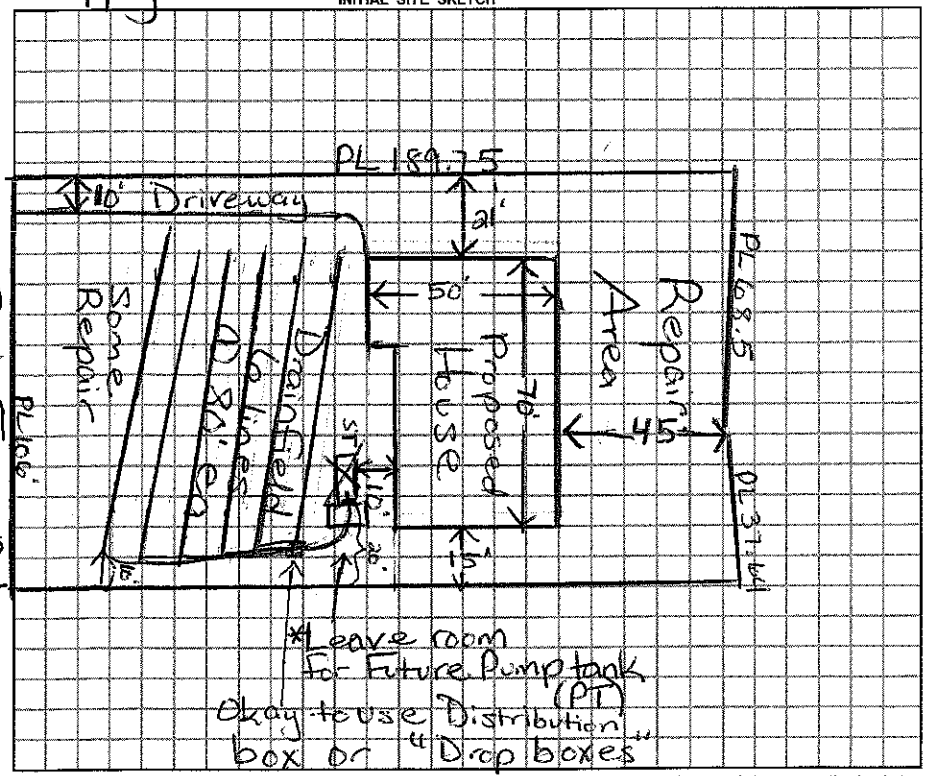

Sink Farm Rd.

AS BUILT SKETCH

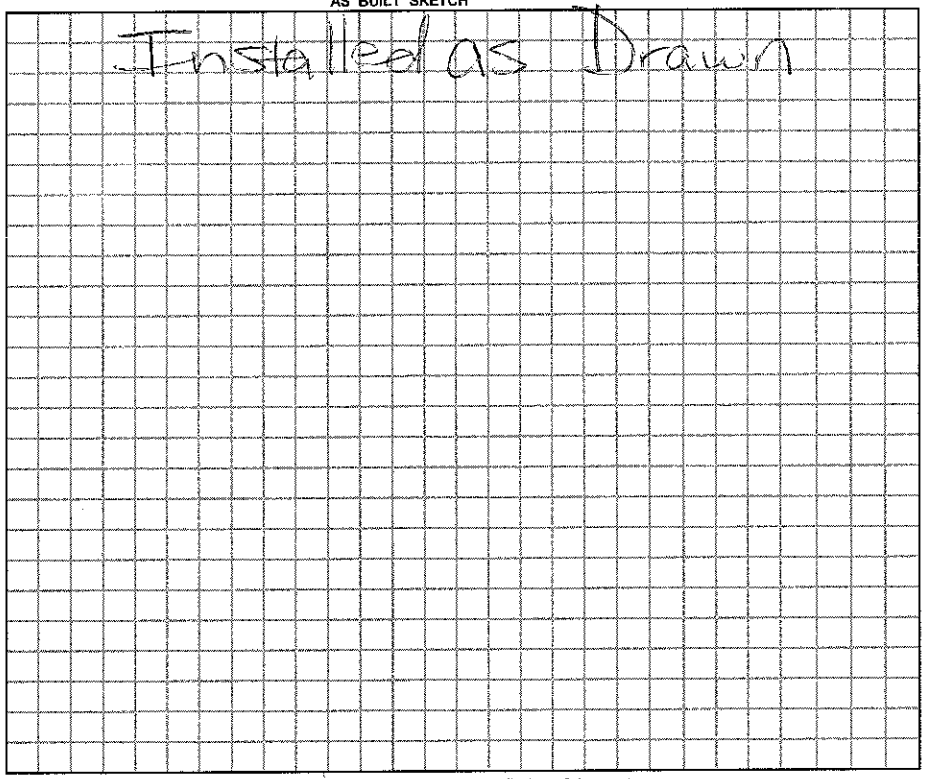

Permit can be suspended or revoked if any false information is supplied toward securing the permit / any unauthorized changes are made to the site / any unauthorized changes are made in the installation of the system.

☐ IMPROVEMENT PERMIT w / plat valid without expiration. ☐ IMPROVEMENT PERMIT w / site plan valid for 60 mos. ☒ AUTHORIZATION TO CONSTRUCT valid for period equal to IMPROVEMENT PERMIT-not to exceed 60 mo.

Owner / Applicant Signature: Date 10-7-2009

Improvement Permit by: RS Date 10/5/09

Authorization to Construct by: RS Date 10/5/09

YOU SHOULD CONTACT A LOCATOR SERVICE PRIOR TO ANY EXCAVATION.

Installed by: R&H RS

Operation Permit by: RS Date: 7/7/2010

Existing System Inspected by: Date:

WHITE COPY Environmental Health YELLOW COPY (Final) Owner / Applicant PINK COPY (Initial) Owner / Applicant