Noon

IREDELL COUNTY HEALTH DEPARTMENT

STATESVILLE 704-878-5305 MOORESVILLE 704-664-5281

IMPROVEMENT PERMIT / AUTHORIZATION TO CONSTRUCT / OPERATION PERMIT / EXISTING SYSTEM INSPECTION

PERMIT# 115708 PIN# 4654 77 4380 DATE 2/6/06

OWNER OR APPLICANT Fred Caldwell Jr. PHONE: Business 704-562-3007 Home 704-895-4674

ADDRESS 14630 Stumptown Rd. Huntersville, NC. 28078

LOCATION 115 S TL Pitts Farm Rd. TR Sink Farm Rd., Lot on (R) First on Right

SUBDIVISION Davidson Down BLOCK / SECTION 2 LOT 117 LOT AREA .45Ac SITE CLASS. PS DESIGN FLOW 480 L.T.A.R. .3

Septic Tank: 1000 Gallons; STB 312 Date 6-05-06
Pump Tank: _____ Gallons; PT _____ Date _____
Pump Make: _____ Model _____ Serial No. _____
Nitrification Field: No Fields 1 Square Feet 640 Linear Feet 320
No Lines 4@80 Trench Width 2' Max Trench Bottom Depth 3'

☒ New System ☐ Repair ☐ Expansion System Type: I II (III) IV V VI
System Description: GRAVITY - 16" PPBPS
Repair System Description: SAME TYPE
Maintenance Agreement Required: ☐ Yes ☒ No

☒ House/Mod. Home ☐ Mobile Home ☐ Business ☐ Other
No. Bedrooms 4 No. Persons 4 No. Employees ____


Water Supply: ☐ Individual ☐ Public ☒ Community

Gravel Depth NA ☐ Gravity ☐ Pressure ☐ Slab ☒ Crawl Space ☐ Basement w/plumbing ☐ Basement wo/plumbing

Comments:/Conditions: Center Feed from Drop Boxes 40' per line segment from Drop Box
Tight Site - No Room FOR ERRORS


Comments:/Conditions: blue polylok filter STW/ marker & risers

INITIAL SITE SKETCH 1"=40'

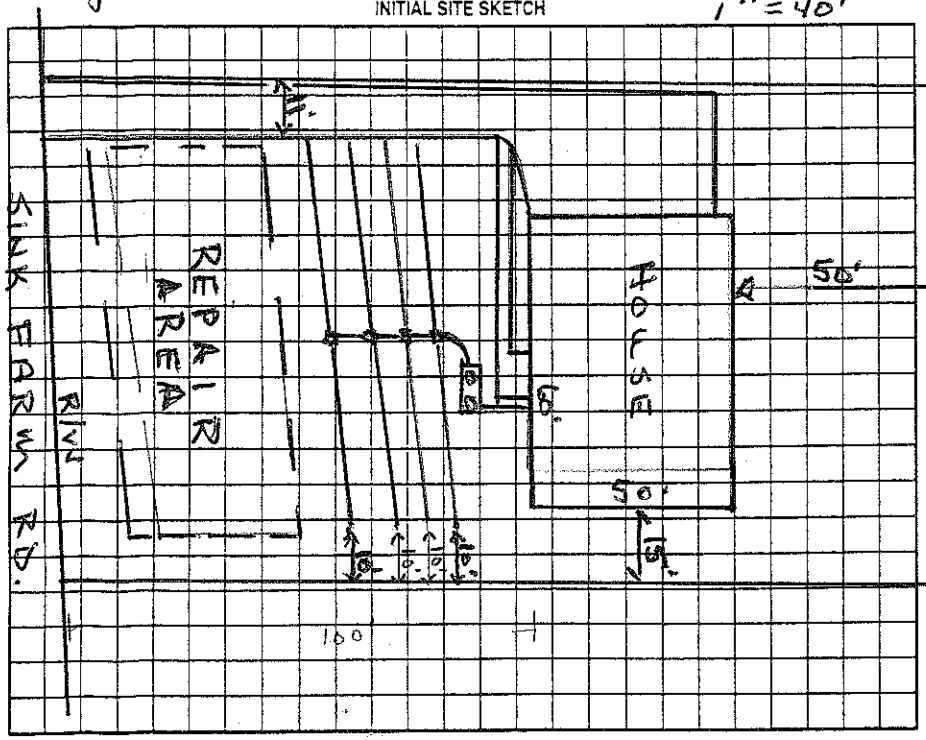

AS BUILT SKETCH

Installed as per initial site sketch
1st line at top right deeper at right end

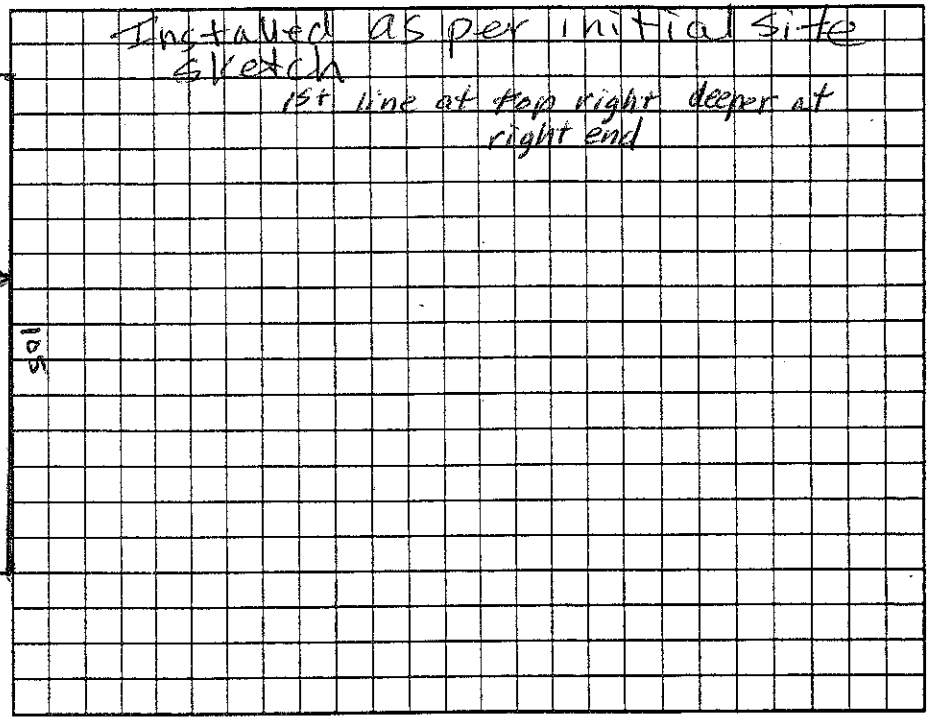

Permit can be suspended or revoked if any false information is supplied toward securing the permit/any unauthorized changes are made to the site/any unauthorized changes are made in the installation of the system. Improvement Permit with plat valid without expiration ☐ Improvement Permit with site plan valid for sixty months ☐ Authorization to Construct is valid for a period equal to that of Improvement Permit – not to exceed sixty months.

Signed: Fred W Caldwell date 2-7-06

Improvement Permit by: Wesley Sparks RS. date 2/6/06

Authorization to Construct by: Wesley Sparks RS date 2/6/06

Installed by: Stewart Grading 704-507-7281

Operation Permit by: Judy Melville date 7-19-06

Existing System Inspection by: _____ date _____

HEALTH DEPT. COPY: WHITE OWNER COPY (FINAL): YELLOW OWNER COPY (INITIAL): PINK