PIN# 4654-77-4783

IREDELL COUNTY HEALTH DEPARTMENT

LE 704-878-5305 MOORESVILLE 704-664-5281

IMPROVEMENT PERMIT / CERTIFICATE OF COM... OPERATION PERMIT / EXISTING SYSTEM INSPECTION

PROPERTY DESCRIPTION NO. 17265 DATE 10/25/93 TAX MAP NO. IC-7-A-6 Watershed: ☑ Yes ☐ No

OWNER OR CONTRACTOR KARL GERWITZ PHONE: Business _____ Home 596-2259

ADDRESS SINK FARM RD, TR OFF PRESBYTERIAN RD. 4th lot on (L)

LOCATION _____

SUBDIVISION DAVIDSON DOWNS BLOCK / SECTION 2 LOT 47 LOT AREA ~23,000 FT² SITE CLASS. P DESIGN FLOW 360 L.T.A.R. .3

Septic Tank: 1000 Gallons; STB 794 Date 5/2/94
Pump Tank: _____ Gallons; PT _____ Date _____
Pump Make: _____ Model _____ Serial No. _____
Nitrification Field: No Fields 1 Square Feet 1200 Linear Feet 400
No Lines 5 Trench Width 3' Max Trench Bottom Depth 30" Gravel Depth 12"

☑ New System ☐ Repair System Type: I (II) III, IV, V, VI
System Description: CONV - DIST. BOX
Repair System Description: _____
Maintenance Agreement Required: ☐ Yes ☐ No

☑ House/Mod. Home No. Bedrooms 3
☐ Mobile Home No. Bathrooms 2.5
☐ Business No. Employees _____
☐ Other _____


☐ Slab ☑ Crawl Space ☐ Basement w/plumbing ☐ Basement wo/plumbing

Water Supply:
☐ Individual
☑ Community
☐ Public

Comments: TRENCH BOTTOM NO DEEPER THAN 30" LINE ON CONTOUR IN DIRECTION

Comments:

INITIAL SITE SKETCH

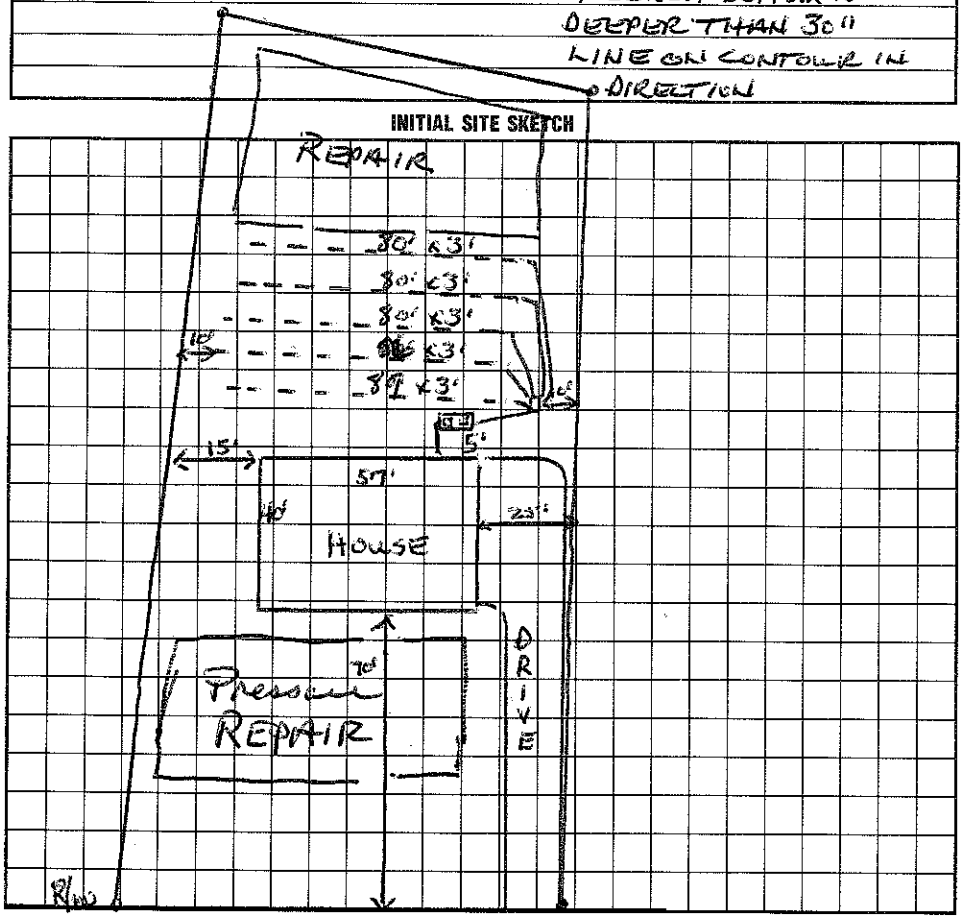

AS BUILT SKETCH

Installed as shown on IP

I understand that this permit can be suspended or revoked if any false information is supplied toward securing the permit/any unauthorized changes are made to the site/any unauthorized changes are made in the installation of the system. Improvement Permit is valid for 60 months from date of issuance.

Signed: Karl M Gerwitz

Improvement Permit by: Wesley Sparks R.S. date 10/25/93

Existing System Inspection by: _____ date _____

Installed by: Bob Mayhew

Certificate of Completion by: Wesley Sparks R.S. date 7/14/94

Operation Permit by: _____ date _____

HEALTH DEPT. COPY: WHITE INSPECTION COPY (FINAL): GREEN OWNER COPY (FINAL): YELLOW INSPECTION COPY (INITIAL): PINK OWNER COPY (INITIAL): GOLD