IREDELL COUNTY HEALTH DEPARTMENT

STATESVILLE 704-878-5305 MOORESVILLE 704-664-5281

IMPROVEMENT PERMIT / AUTHORIZATION TO CONSTRUCT / OPERATION PERMIT / EXISTING SYSTEM INSPECTION

PERMIT# 115710 PIN# 4654 77 5242 DATE 1/9/04

OWNER OR CONTRACTOR LECHE HOMES LLC / TAYLORED CUSTOM PHONE: Business 658-7786 Home

ADDRESS PO BOX 1543 MOORESVILLE NC 28115

LOCATION 115 (S) - TL PRESBYTERIAN - TR SINK FARM - ON RT

SUBDIVISION DAVIDSON DOWNES BLOCK / SECTION 2 LOT 118 LOT AREA .764C SITE CLASS. P3 DESIGN FLOW 480GPD L.T.A.R. .30-50/EC-2

Septic Tank: 1000 Gallons; STB 1007 Date 4/27/06
Pump Tank: ____ Gallons; PT ____ Date ____
Pump Make: ____ Model ____ Serial No. ____
Nitrification Field: No Fields 1 Square Feet 560 Linear Feet 280
No Lines 7@40' Trench Width 36 24" Max Trench Bottom Depth 36" Gravel Depth ____

☑ New System ☐ Repair System Type: I, II, (III), IV, V, VI
System Description: GRAVITY PANEL
Repair System Description: LP PANEL
Maintenance Agreement Required: ☐ Yes ☑ No


☑ House/Mod. Home No. Bedrooms 4
☐ Mobile Home No. Bathrooms 4
☐ Business No. Employees ____
☐ Other ____
☐ Slab ☑ Crawl Space ☐ Basement w/plumbing ☐ Basement wo/plumbing

Water Supply:
☐ Individual
☐ Public
☐ ~~Community~~

Comments:/Conditions:

Comments:/Conditions:

INITIAL SITE SKETCH 1" = 50'

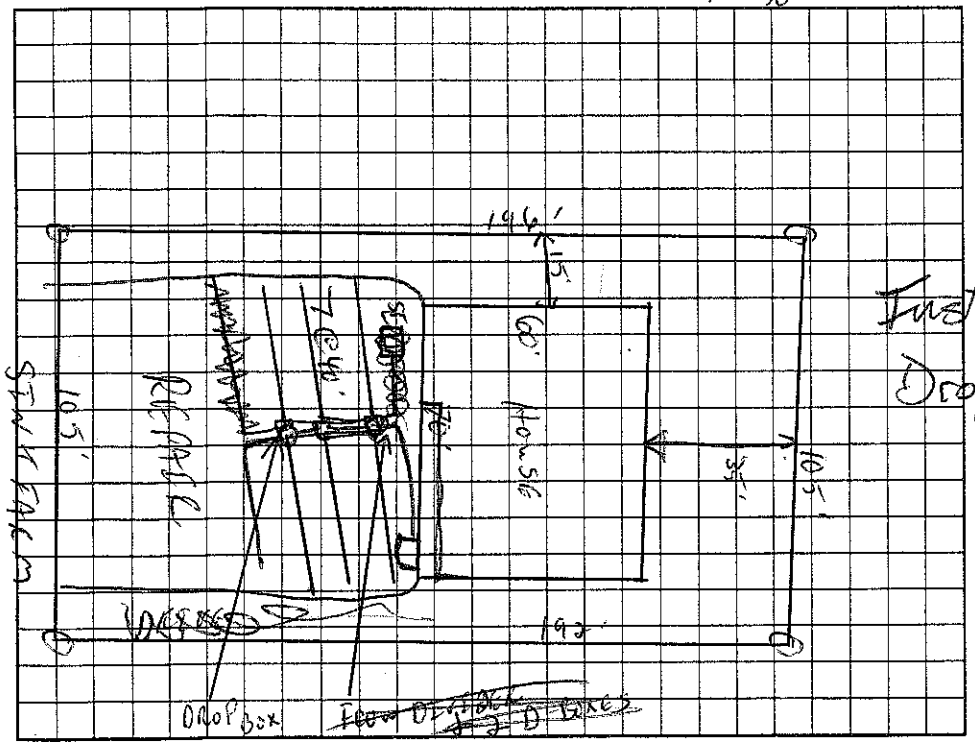

Install on Drop Boxes

AS BUILT SKETCH

Permit can be suspended or revoked if any false information is supplied toward securing the permit/any unauthorized changes are made to the site/any unauthorized changes are made in the installation of the system. Improvement Permit with plat valid without expiration. Improvement Permit with site plan valid for sixty months. Authorization to Construct is valid for a period equal to that of Improvement Permit – not to exceed sixty months.

Signed: [signature] date 1/29/04 Installed by: Abernathy

Improvement Permit by: [signature] RS date 1/9/04 Operation Permit by: [signature] date 6/20/06

Authorization to Construct by: Wesley Sparks RS. date 11/7/05 Existing System Inspection by: ____ date ____

HEALTH DEPT. COPY: WHITE OWNER COPY (FINAL): YELLOW OWNER COPY (INITIAL): PINK