IREDELL COUNTY HEALTH DEPARTMENT

Statesville Office (704) 878-5305 | Mooresville Office (704) 660-3625 | PERMIT # 211975

IMPROVEMENT PERMIT / AUTHORIZATION TO CONSTRUCT / OPERATION PERMIT / EXISTING SYSTEM

PIN # 4654776103

APPLICANT: Patty Ketron/Aloha Pools APPLICANT ADDRESS: 150 Sink Farm Rd Mooresville, NC 28115

SITE ADDRESS: 150 Sink Farm Rd; Mrsvl. PHONE: 704 301-4456 ALT. PHONE: 980-258-1694

SITE DIRECTIONS: Hwy 115 S. TL Presbyterian Rd TR Sink Farm Rd on right

SUBDIVISION: Davidson Downs SECTION: LOT # 119 LOT AREA: .46 Ac DESIGN FLOW: 360 L.T.A.R.: .3

Septic Tank 1600 (gal) STB Date

Pump Tank (gal) PT Date

Pump Make Model Serial #

Nitrification Fields 1 # Lines 6 Linear Ft: 210'

Trench Width 24-36" Max. Trench Bottom Depth 36" Gravel Depth N/A

☐ New System ☐ Repair ☐ Expansion System Type: I II (III) IV V VI

System Description: Exist. Gravity - PPBPS

Repair System Description: Same

Maintenance Agreement Required: ☐ YES ☒ NO

☒ GRAVITY ☐ PRESSURE

☒ Residence No. Bedrooms 3

☐ Business No. Persons 6

☐ Other No. Employees

☐ Slab ☒ Crawl Space


☐ Basement w/plumbing ☐ Basement w/o plumbing

Water Supply: ☐ Private ☐ Public ☐ Community


Comments / Conditions:

The proposed inground swimming pool does not appear to impact the existing septic system.

INITIAL SITE SKETCH

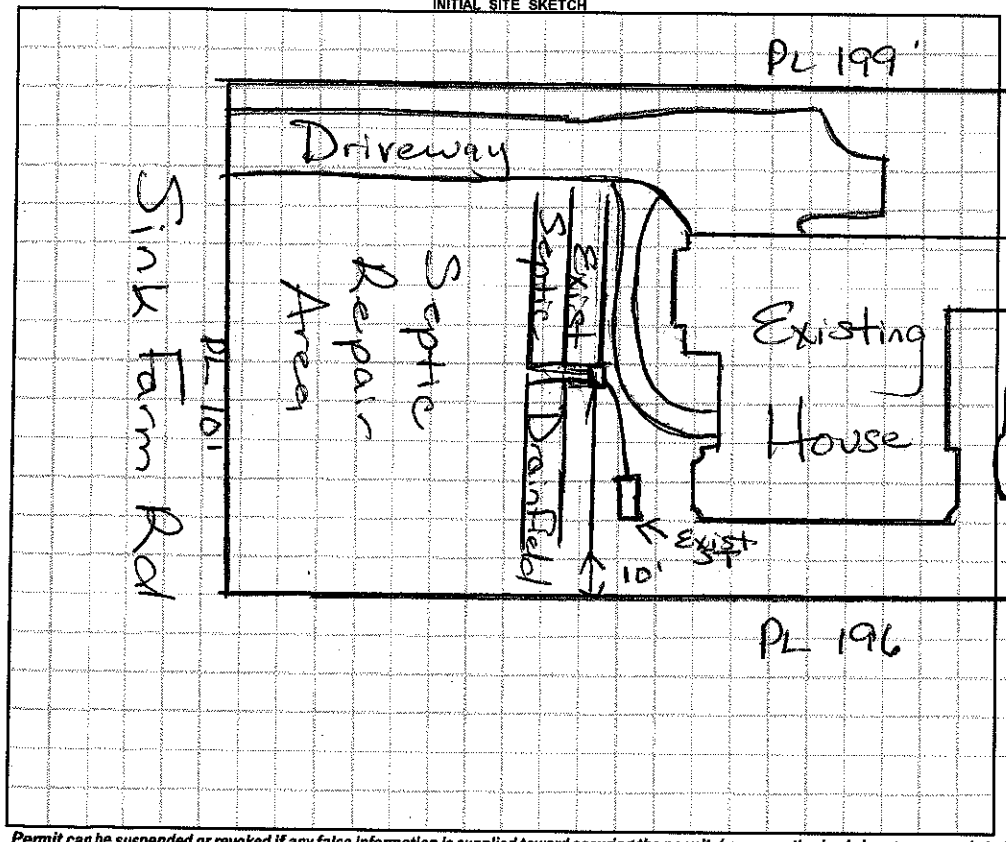

AS BUILT SKETCH

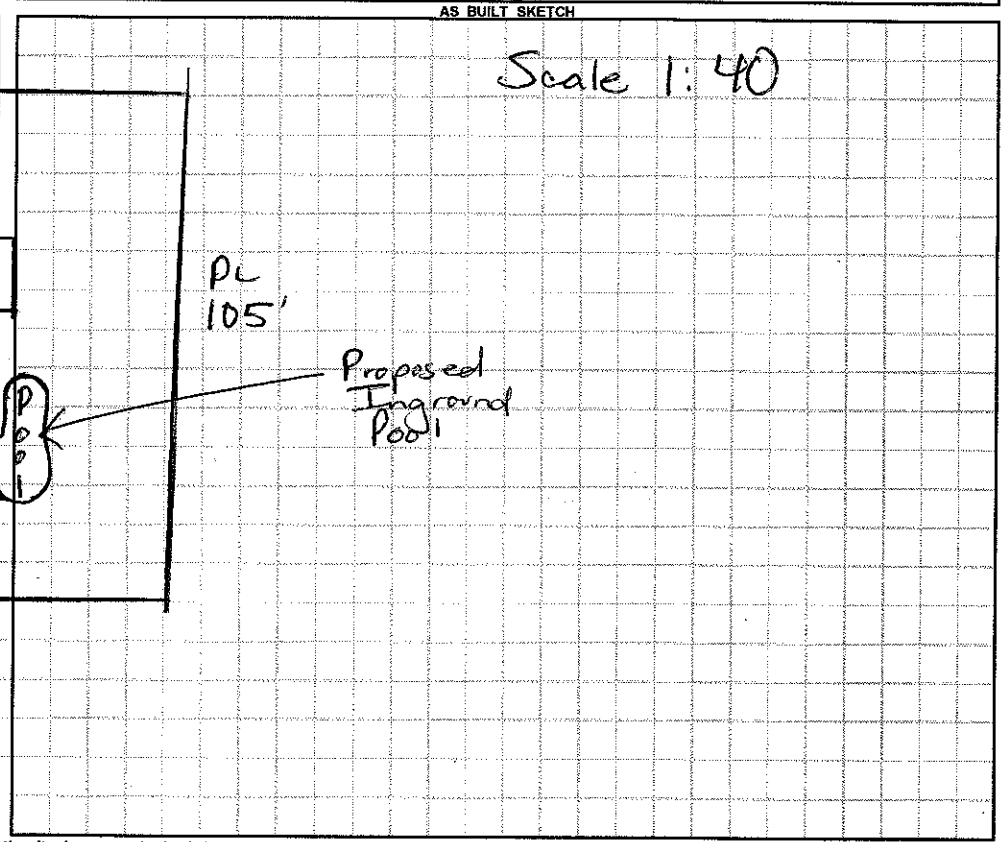

Permit can be suspended or revoked if any false information is supplied toward securing the permit / any unauthorized changes are made to the site / any unauthorized changes are made in the installation of the system. **CONTACT A LOCATOR SERVICE PRIOR TO ANY EXCAVATION**

☐ **IMPROVEMENT PERMIT** *with plat valid without expiration.* ☐ **IMPROVEMENT PERMIT** *with site plan valid for 60 mos.* ☐ **AUTHORIZATION TO CONSTRUCT** *valid for period equal to IMPROVEMENT PERMIT--not to exceed 60 mo.*

Owner / Applicant Signature: [signature] Date: 9-1-15 Installed by:

IMPROVEMENT PERMIT by: Date: OPERATION PERMIT by: Date:

AUTHORIZATION TO CONSTRUCT by: Date: Existing System Inspected by: Maria Dotson RS Date: 8/10/15

Health Dept. Copy - WHITE Applicant (Final Approval) - YELLOW Applicant (Conditional Approval) - PINK