IREDELL COUNTY HEALTH DEPARTMENT

Statesville Office (704) 878-5305 Mooresville Office (704) 660-3625 PERMIT # 206071

IMPROVEMENT PERMIT / AUTHORIZATION TO CONSTRUCT / OPERATION PERMIT / EXISTING SYSTEM

PIN # 4654-77-6477

APPLICANT: Daniel Williams APPLICANT ADDRESS: 137 Sink Farm Rd Mooresville NC 28115

SITE ADDRESS: 137 Sink Farm Rd PHONE: 704 604 5141 ALT. PHONE:

SITE DIRECTIONS: ~~Davidson~~ Go 115 S. TL Presbyterian Rd TR Sink Farm Rd lot on left

SUBDIVISION: Davidson Downs SECTION: LOT # 43 LOT AREA: .4 ac DESIGN FLOW: 480 L.T.A.R.: N/A

Septic Tank existing 1000 STB Date
Pump Tank (gal) PT Date
Pump Make Model Serial #
Nitrification Fields 1 # Lines 5 Linear Ft: 400
Trench Width 36" Max. Trench Bottom Depth 3'-4' Gravel Depth N/A


☐ New System ☐ Repair ☐ Expansion System Type: I II III IV V VI
System Description: 400' 5 lines 25% reduct chamber
Repair System Description: LPP panel block
Maintenance Agreement Required: ☐ YES ☐ NO
☑ GRAVITY ☐ PRESSURE

☑ Residence No. Bedrooms 4
☐ Business No. Persons
☐ Other No. Employees
☐ Slab ☑ Crawl Space
☐ Basement w/plumbing ☐ Basement w/o plumbing

Water Supply: ☑ Private ☑ Public ☐ Community

Comments / Conditions: This is an existing system reuse permit for a covered screened porch over existing deck - No increase in bedrooms or gal/day. above 4BR (480 gpd max)

INITIAL SITE SKETCH

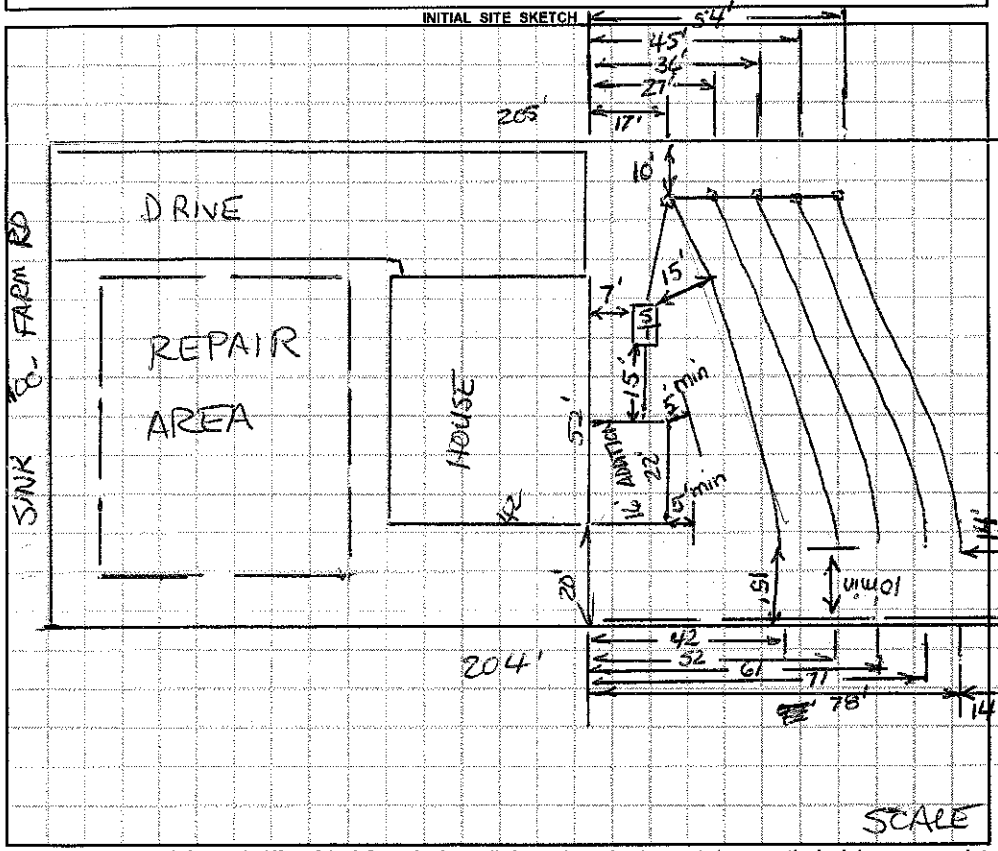

AS BUILT SKETCH

Permit can be suspended or revoked if any false information is supplied toward securing the permit / any unauthorized changes are made to the site / any unauthorized changes are made in the installation of the system. **CONTACT A LOCATOR SERVICE PRIOR TO ANY EXCAVATION**

☐ **IMPROVEMENT PERMIT** *with plat valid without expiration.* ☐ **IMPROVEMENT PERMIT** *with site plan valid for* *PERMIT--not to exceed 60 mo.*

Owner / Applicant Signature: Daniel Williams Date: 9/7/2014

IMPROVEMENT PERMIT by: Date:

AUTHORIZATION TO CONSTRUCT by: Date:

Location of the proposed porch/deck addition does not appear to impact the existing on-site septic system or well.**NOTE:

Richard Farris REHS Date: 10/7/14
ICHD-Environmental Health Division

Date:

Date:

Health Dept. Copy - WHITE Applicant (Final Approva