PIN# 4654-77-7348

IREDELL COUNTY HEALTH DEPARTMENT

STATESVILLE 704-878-5305 MOORESVILLE 704-664-5281

IMPROVEMENT PERMIT / CERTIFICATE OF COMPLETION / OPERATION PERMIT / EXISTING SYSTEM INSPECTION

PROPERTY DESCRIPTION NO. 17443 DATE 11/22/93 TAX MAP NO. IC 7A 11 Watershed: ☒ Yes ☐ No

OWNER OR CONTRACTOR CLODFELTER BUILDERS PHONE: Business 664-1812 Home

ADDRESS SINK FARM RD.

LOCATION SINK FARM - ON (L) to 8th lot ON (L)

SUBDIVISION DAVIDSON DOWNS BLOCK / SECTION 2 LOT 42 LOT AREA SITE CLASS. P DESIGN FLOW 360 L.T.A.R. .3 - 1.35

Septic Tank: 1000 Gallons; STB 794 Date 12/16/93

Pump Tank: Gallons; PT Date

Pump Make: Model Serial No.

Nitrification Field: No Fields 1 Square Feet 1350 Linear Feet 450

No Lines 5 Trench Width 3' Max Trench Bottom Depth 3 Gravel Depth

☒ New System ☐ Repair System Type: I (II) III, IV, V, VI

System Description: CONV - DIST BOX

Repair System Description:

Maintenance Agreement Required: ☐ Yes ☒ No

☒ House/Mod. Home No. Bedrooms 3

☐ Mobile Home No. Bathrooms 2

☐ Business No. Employees

☐ Other


☐ Slab ☐ Crawl Space ☐ Basement w/plumbing ☐ Basement wo/plumbing

Water Supply:
☐ Individual
☒ Community
☐ Public

Comments: ~~SPECIAL LETTERS REQUIRED~~ AWS 3/15/94

Comments: Installed essentially as shown. AWS.

INITIAL SITE SKETCH

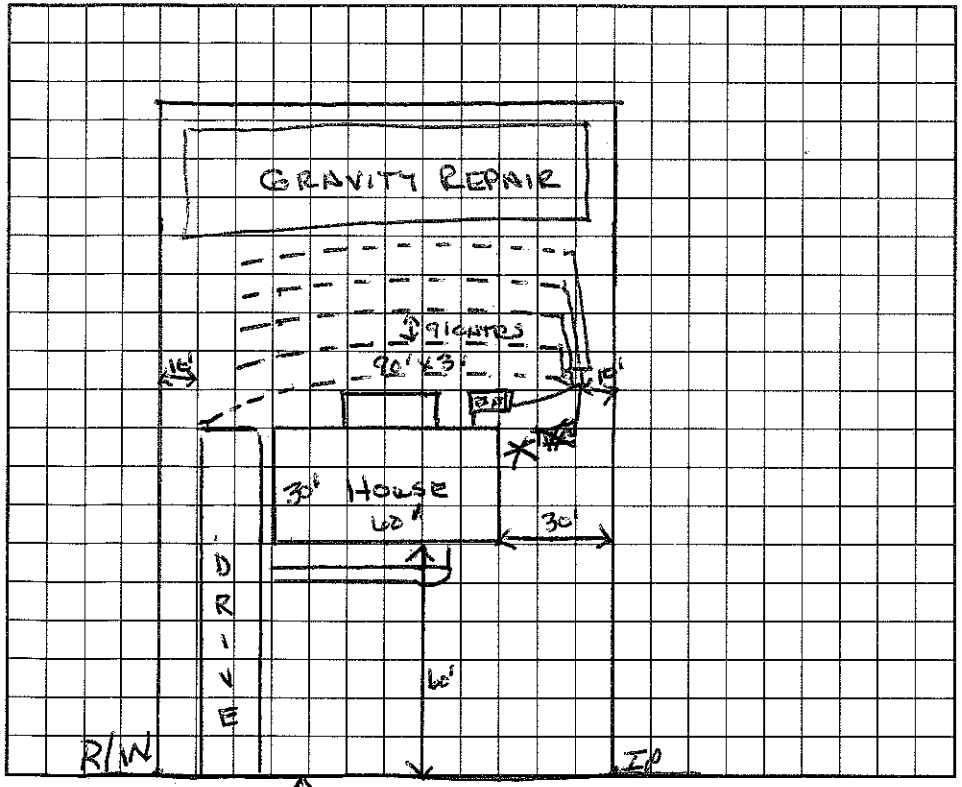

AS BUILT SKETCH

I understand that this permit can be suspended or revoked if any false information is supplied toward securing the permit/any unauthorized changes are made to the site/any unauthorized changes are made in the installation of the system. Improvement Permit is valid for 60 months from date of issuance.

Signed: Molly Clodfelter

Improvement Permit by: Wesley Sparks R.S. date 11/22/93

Existing System Inspection by: date

Installed by: J. Bowles

Certificate of Completion by: Wesley Sparks R.S. date 3/15/94

Operation Permit by: date

HEALTH DEPT. COPY: WHITE INSPECTION COPY (FINAL): GREEN OWNER COPY (FINAL): YELLOW INSPECTION COPY (INITIAL): PINK OWNER COPY (INITIAL): GOLD