IREDELL COUNTY HEALTH DEPARTMENT

STATESVILLE 704-878-5305 MOORESVILLE 704-664-5281

IMPROVEMENT PERMIT / AUTHORIZATION TO CONSTRUCT / OPERATION PERMIT / EXISTING SYSTEM INSPECTION

PERMIT# 138872 PIN# 4654 78 2647 3002 DATE 11/9/06

OWNER OR APPLICANT DAVIDSON DOWNES INC PHONE: Business 704-896-0016 Home

ADDRESS 4643 MARINER LN DENVER, NC. 28037

LOCATION 115 S TL PRESBYTERIAN RD TR SINK FARM RD. ON (L) CORNER

SUBDIVISION DAVIDSON DOWNES BLOCK / SECTION 2 LOT 51+52 LOT AREA ~1AC SITE CLASS. PS DESIGN FLOW 480 L.T.A.R. .3

Septic Tank: 1000 Gallons: STB 794 Date 3/21/07

Pump Tank: Gallons; PT Date

Pump Make: Model Serial No.

Nitrification Field: No Fields 1 Square Feet 1200 Linear Feet 400

No Lines 5@80' Trench Width 3' Max Trench Bottom Depth 3'

☒ New System ☐ Repair ☐ Expansion System Type: I II (III) IV V VI

System Description: GRAVITY -25% REDUCTION

Repair System Description:

Maintenance Agreement Required: ☐ Yes ☐ No

☐ House/Mod. Home No. Bedrooms 4 ~~3~~

☐ Mobile Home No. Persons

☐ Business No. Employees

☐ Other

Water Supply: ☐ Individual ☐ Public ☐ Community


Gravel Depth No ☐ Gravity ☐ Pressure ☐ Slab ☐ Crawl Space ☐ Basement w/plumbing ☐ Basement wo/plumbing

Comments:/Conditions:


Comments:/Conditions: IQ4W INSTALLED

PRESBYTERIAN RD.

INITIAL SITE SKETCH

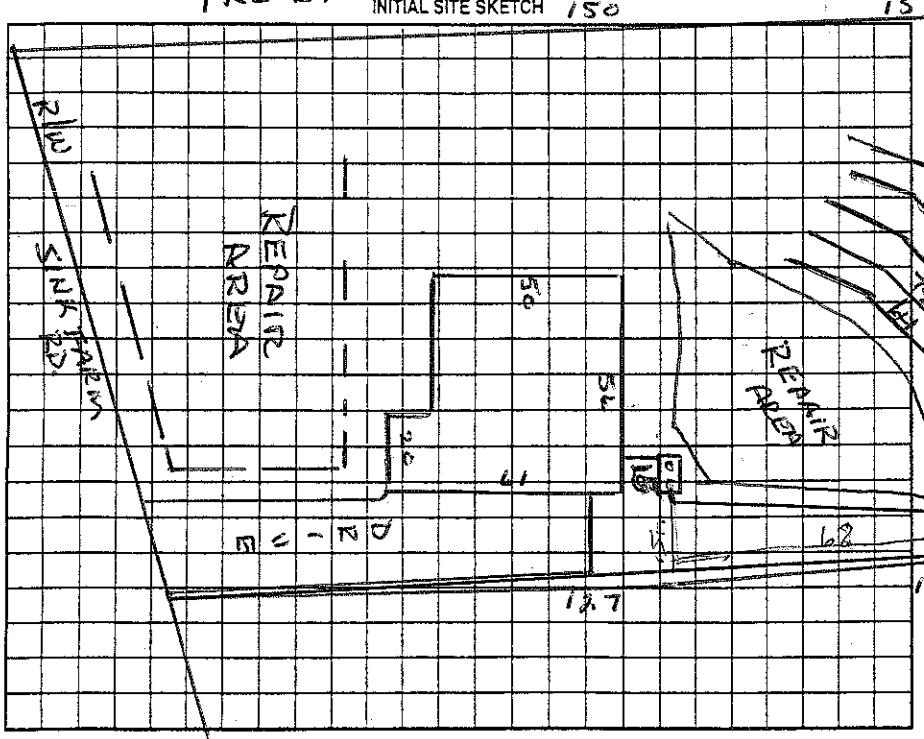

AS BUILT SKETCH

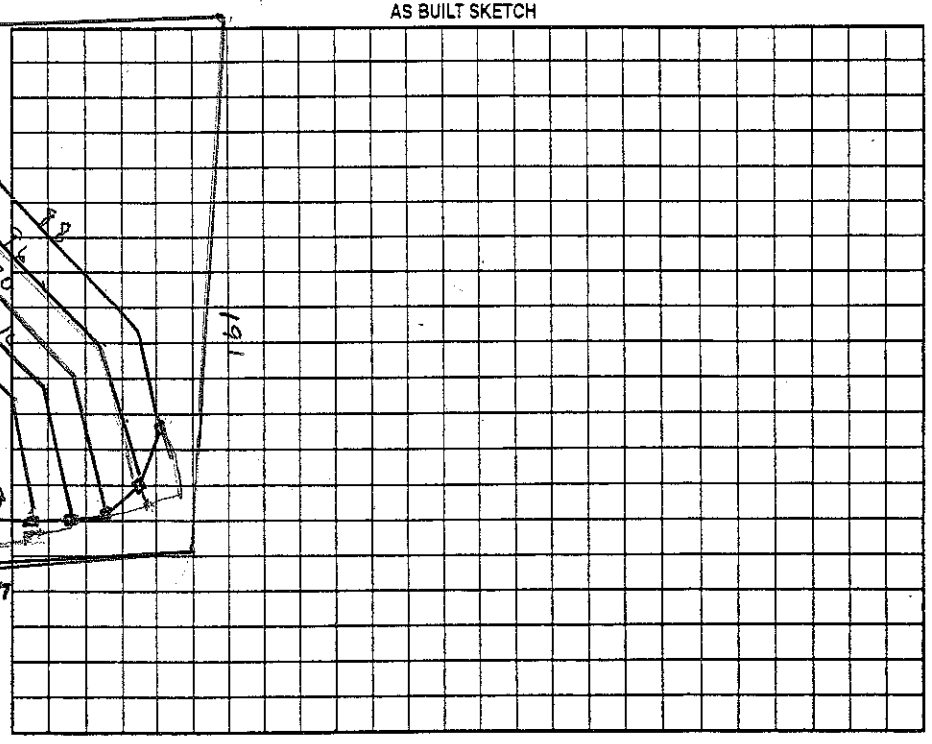

Permit can be suspended or revoked if any false information is supplied toward securing the permit/any unauthorized changes are made to the site/any unauthorized changes are made in the installation of the system. Improvement Permit with plat valid without expiration ☐ Improvement Permit with site plan valid for sixty months ☐ Authorization to Construct is valid for a period equal to that of Improvement Permit – not to exceed sixty months.

Signed: [signature] date 12-8-06 Installed by: Larry Henkle

Improvement Permit by: Wesley Sparks RS. date 11/9/06 Operation Permit by: Wesley Sparks RS. date 5/16/07

Authorization to Construct by: Wesley Sparks RS date 11/9/06 Existing System Inspection by: date

HEALTH DEPT. COPY: WHITE OWNER COPY (FINAL): YELLOW OWNER COPY (INITIAL): PINK