IREDELL COUNTY HEALTH DEPARTMENT

AUTHORIZATION TO CONSTRUCT (2,50-3,00)

STATESVILLE 704-878-5305 MOORESVILLE 704-664-5281

IMPROVEMENT PERMIT / ~~CERTIFICATE OF COMPLETION~~ / OPERATION PERMIT / EXISTING SYSTEM INSPECTION

PROPERTY DESCRIPTION NO. 070256 DATE 11/26/97 TAX MAP NO. 4654792929 Watershed: ☒ Yes ☐ No

OWNER OR CONTRACTOR CURTIS MULLEN PHONE: Business _____ Home 896-4976

ADDRESS 134 LANTREE RD - MOORESVILLE NC 28115

LOCATION 115 S- TL FAITH -TR MIDWAY LAKE - TL BERACAH - ON RT

SUBDIVISION BERACAH PL BLOCK / SECTION — LOT 7 LOT AREA — SITE CLASS. PS DESIGN FLOW 360 L.T.A.R. .3

Septic Tank: 1000 Gallons; STB 794 Date 7-4-99

Pump Tank: _____ Gallons; PT _____ Date _____

Pump Make: _____ Model _____ Serial No. _____

Nitrification Field: No Fields 1 Square Feet 900 Linear Feet 300

No Lines 3@100' Trench Width 36" Max Trench Bottom Depth 36" Gravel Depth N/A

☒ New System ☐ Repair System Type: I II III IV, V, VI

System Description: GRAVITY CHAMBERED ORMS

Repair System Description: PUMP CHAMBERED ORMS

Maintenance Agreement Required: ☐ Yes ☒ No

☒ House/Mod. Home No. Bedrooms 3

☐ Mobile Home No. Bathrooms 2

☐ Business No. Employees ____

☐ Other _____


☐ Slab ☒ Crawl Space ☒ Basement w/plumbing ☐ Basement wo/plumbing

Water Supply: ☒ Individual ☐ Community ☐ Public


Comments: Filter not installed — not needed.

Comments: ST moved slightly to Right side, deck on left side
Well installed in Front

INITIAL SITE SKETCH

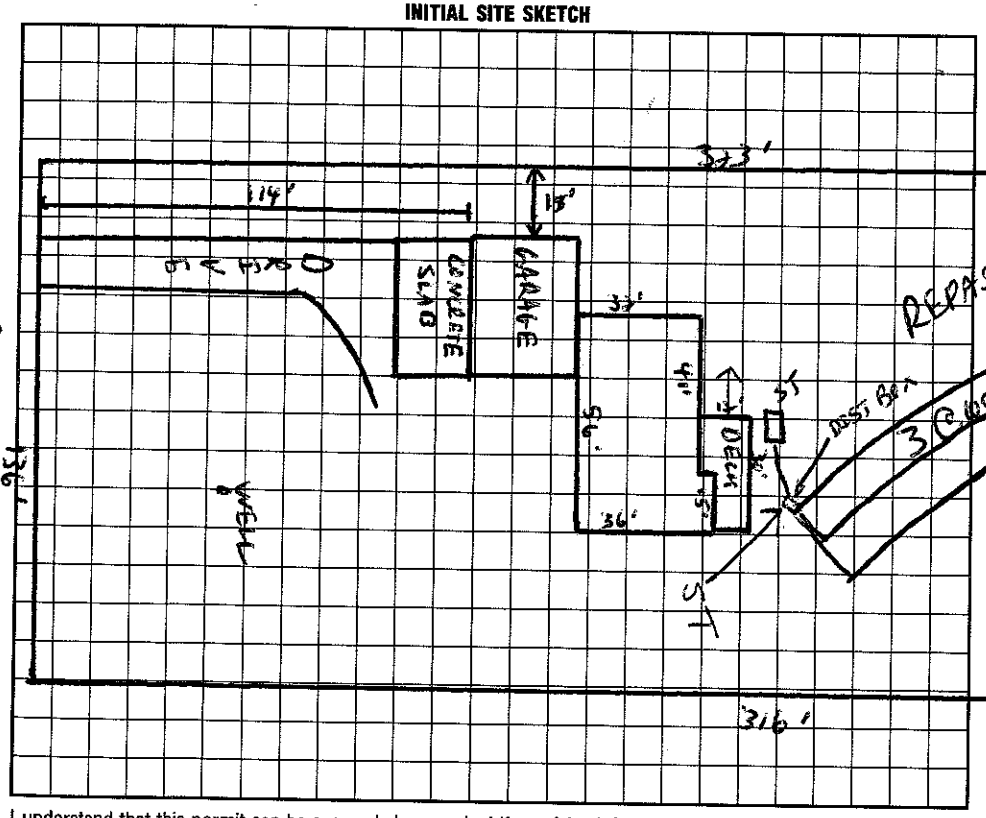

AS BUILT SKETCH

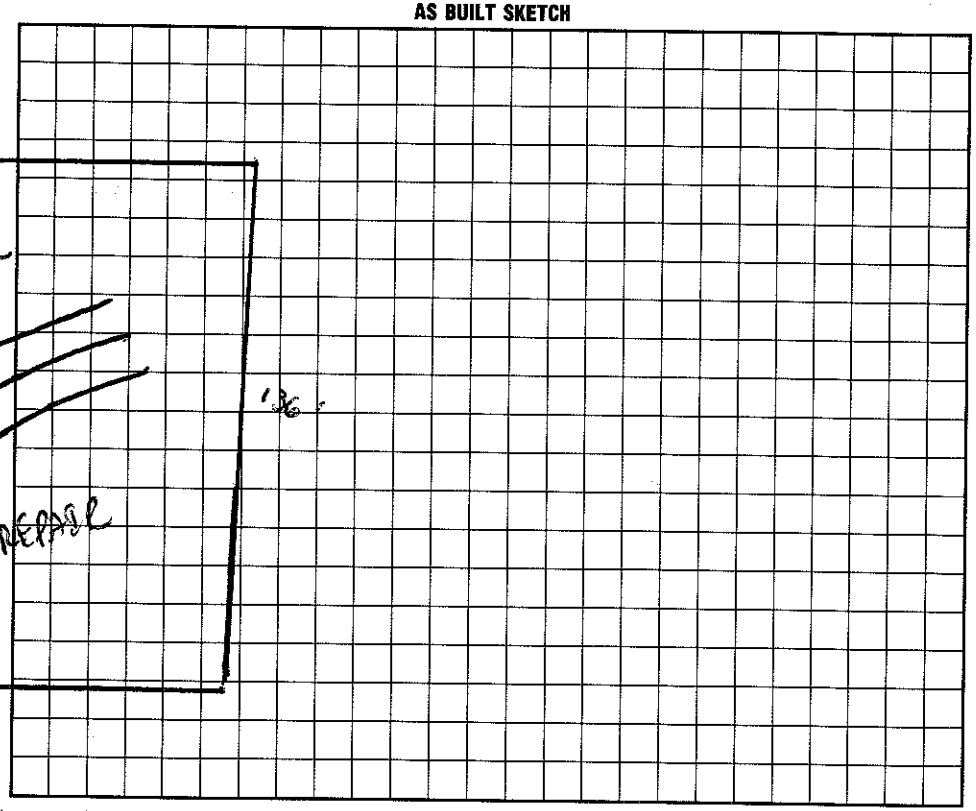

I understand that this permit can be suspended or revoked if any false information is supplied toward securing the permit/any unauthorized changes are made to the site/any unauthorized changes are made in the installation of the system. Improvement Permit is valid for 60 months from date of issuance.

Signed: Curtis Mullen

Improvement Permit by: C. Ray Tatum RS date 11/26/97

AUTHORIZATION TO CONSTRUCT ~~Existing System Inspection by:~~ C. Ray Tatum RS date 11/26/97

Installed by: Curt Dunning

Certificate of Completion by: Maria Dotson date 8/26/99

Operation Permit by: Maria Dotson RS date 8/26/99

HEALTH DEPT. COPY: WHITE INSPECTION COPY (FINAL): GREEN OWNER COPY (FINAL): YELLOW INSPECTION COPY (INITIAL): PINK OWNER COPY (INITIAL): GOLD