IREDELL COUNTY HEALTH DEPARTMENT

STATESVILLE 704-878-5305 MOORESVILLE 704-664-5281

IMPROVEMENT PERMIT / CERTIFICATE OF COMPLETION / OPERATION PERMIT / EXISTING SYSTEM INSPECTION

PROPERTY DESCRIPTION NO. 17631 DATE 12/28/93 TAX MAP NO. 1C 9 A9 4985 Watershed: ☑ Yes ☐ No

OWNER OR CONTRACTOR DARRELL L. BRUNER ~~PHONE: Business~~ PIN# 4654-79- Home 531-6699

ADDRESS 7310 LEAWOOD LN CHARLOTTE, NC. 28227

LOCATION MIDWAY LAKE RD, OFF 115S TR TO LOT 9 ON (R) SIDE

SUBDIVISION BERACAH PLACE BLOCK / SECTION ____ LOT 9 LOT AREA 1 AC. SITE CLASS. A DESIGN FLOW 360 L.T.A.R. .25

Septic Tank: 1000 Gallons; STB 794 Date 5-9-96

Pump Tank: ____ Gallons; PT ____ Date ____

Pump Make: ____ Model ____ Serial No. ____

Nitrification Field: No Fields 1 Square Feet 1440 Linear Feet 480

No Lines 5 Trench Width 3 Max Trench Bottom Depth 31 Gravel Depth 12"

☑ New System ☐ Repair System Type: I (II) III, IV, V, VI

System Description: CONV - DROP BOXES

Repair System Description: ____

Maintenance Agreement Required: ☐ Yes ☑ No

☑ House/Mod. Home No. Bedrooms 3

☐ Mobile Home No. Bathrooms 2.5

☐ Business No. Employees ____

☐ Other ____


☐ Slab ☑ Crawl Space ☐ Basement w/plumbing ☐ Basement wo/plumbing

Water Supply: ☑ Individual ☐ Community ☐ Public

Comments: Trenches on slope contour in direction shown.

Comments: 2/15/96 - Tank changed on 5/23/96

INITIAL SITE SKETCH

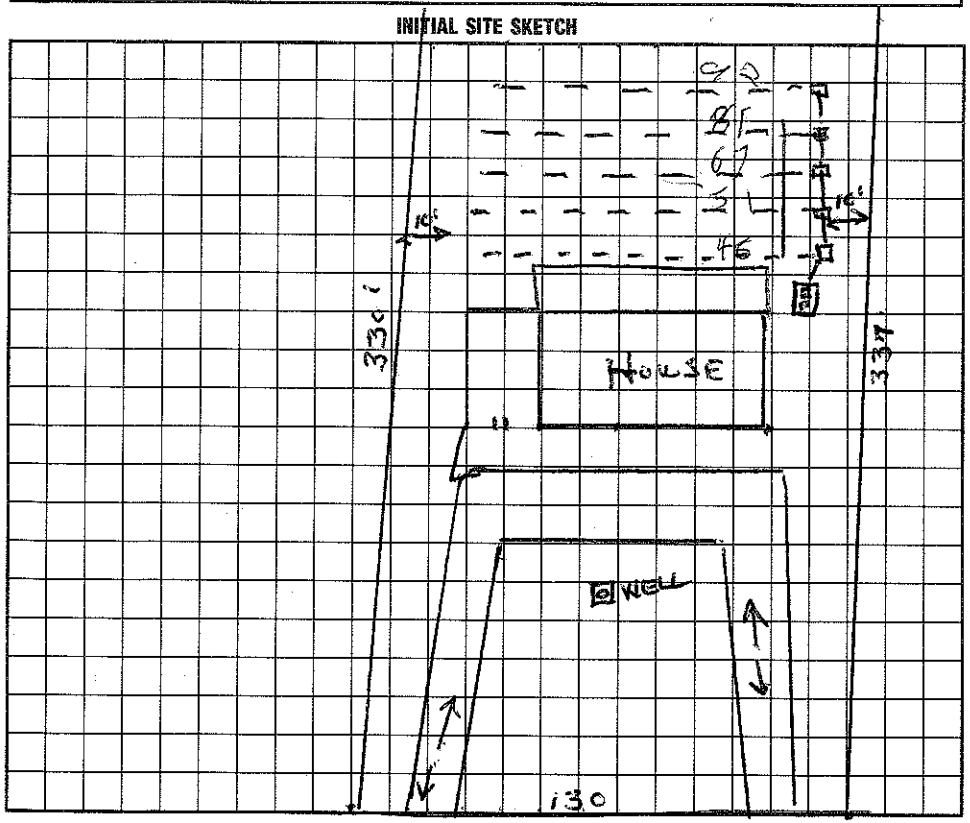

AS BUILT SKETCH

I understand that this permit can be suspended or revoked if any false information is supplied toward securing the permit/any unauthorized changes are made to the site/any unauthorized changes are made in the installation of the system. Improvement Permit is valid for 60 months from date of issuance. BERACAH RD.

Signed: [signature]

Improvement Permit by: Wesley Sparks R.S. date 12/28/93

Existing System Inspection by: ____ date ____

Installed by: FJ Ervin

Certificate of Completion by: ____ date ____

Operation Permit by: C. Brady Teem EHSI date 5/23/96

HEALTH DEPT. COPY: WHITE INSPECTION COPY (FINAL): GREEN OWNER COPY (FINAL): YELLOW INSPECTION COPY (INITIAL): PINK OWNER COPY (INITIAL): GOLD