IREDELL COUNTY HEALTH DEPARTMENT

STATESVILLE 704-878-5305 MOORESVILLE 704-664-5281

IMPROVEMENT PERMIT / CERTIFICATE OF COMPLETION / OPERATION PERMIT / EXISTING SYSTEM INSPECTION

10:00

PROPERTY DESCRIPTION NO. Repair DATE 8/13/97 TAX MAP NO. IC A 67 pt 4654-85-2555 Watershed: ☐ Yes ☐ No

OWNER OR CONTRACTOR Johnny V. Broome Jr PHONE: Business Pager 519-1777 Home 892-6503

ADDRESS 148 Broome Farm Ln. Mooresville, NC 28115

LOCATION Presbyterian TR Sink Farm Rd take to end to gravel road Broome Farm Lane. Bear right (1/4 mile on right)

SUBDIVISION _____ BLOCK / SECTION _____ LOT _____ LOT AREA ~.8 Acre SITE CLASS. PS DESIGN FLOW 240gpd L.T.A.R. .3-.35

Septic Tank: 1000 Exp Gallons; SIBG Date _____

Pump Tank: _____ Gallons; PT _____ Date _____

Pump Make: _____ Model _____ Serial No. _____

Nitrification Field: No Fields 1 Square Feet 660' Linear Feet 220'

No Lines 4 @ 55' Trench Width 36" Max Trench Bottom Depth 36" Gravel Depth _____

☐ New System ☒ Repair System Type: I, (II), III, IV, V, VI

System Description: _____

Repair System Description: Gravity - Conventional

Maintenance Agreement Required: ☐ Yes ☒ No

☐ House/Mod. Home No. Bedrooms 2

☒ Mobile Home No. Bathrooms 1-2

☐ Business No. Employees _____

☐ Other _____

☐ Slab ☒ Crawl Space ☐ Basement w/plumbing ☐ Basement wo/plumbing


Water Supply:
☒ Individual
☐ Community
☐ Public

Comments: Disconnect Existing System that runs onto adjacent lot & only use repair lines.

Keep System as far as possible from existing well ~100'.

Comments:

INITIAL SITE SKETCH Scale ~ 1:60

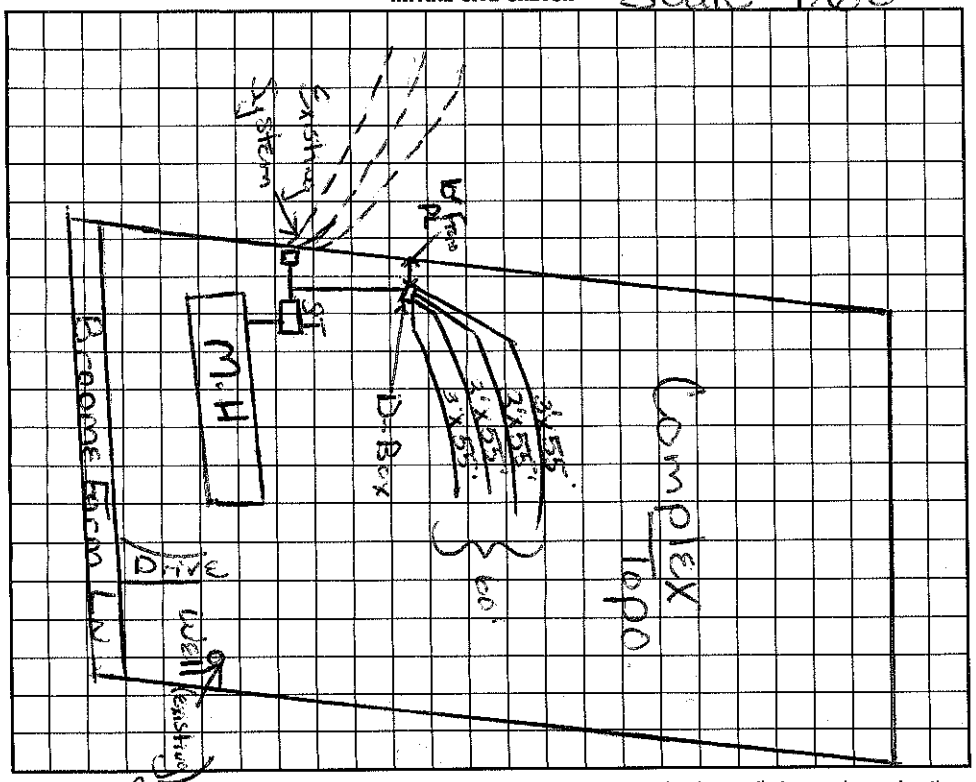

AS BUILT SKETCH

I understand that this permit can be suspended or revoked if any false information is supplied toward securing the Improvement Permit is valid for 60 months from date of issuance. unauthorized changes are made to the site/any unauthorized changes are made in the installation of the system.

Signed: Johnny Broome

Improvement Permit by: Marina H. H. Dotson date 8/14/97

Existing System Inspection by: Marina H. H. Dotson date 8/14/97

stalled by: Johnny Broome Jr.

rtificate of Completion by: Marina H. H. Dotson date 11/21/97

Operation Permit by: Marina H. H. Dotson date 11/21/97

Const. Auth.

HEALTH DEPT. COPY: WHITE INSPECTION COPY (FINAL): GREEN OWNER COPY (FINAL): YELLOW INSPECTION COPY (INITIAL): PINK OWNER COPY (INITIAL): GOLD