IREDELL COUNTY HEALTH DEPARTMENT

STATESVILLE 704-878-5305 MOORESVILLE 704-664-5281

IMPROVEMENT PERMIT / CERTIFICATE OF COMPLETION / OPERATION PERMIT / EXISTING SYSTEM INSPECTION

PROPERTY DESCRIPTION NO. 18534 DATE May 20, '94 TAX MAP NO. IC 7A 38 Watershed: ☒ Yes ☐ No

OWNER OR CONTRACTOR Bryan Cloadfelter ~~PHONE: Business~~ PIN## 4654-86-0493 Home

ADDRESS Rt 1, Box 785 Mooresville

LOCATION 115 S. to Hoskylenan Rd. TR Sink Farm Rd. near end on Rt.

SUBDIVISION Davidson Downes BLOCK / SECTION 2 LOT 126 LOT AREA 110'X200' SITE CLASS. PS DESIGN FLOW 360 gpd L.T.A.R. .3

Septic Tank: 1000 ✓ Gallons; STB 794 Date 5-11-94

Pump Tank: Gallons; PT Date

Pump Make: Model Serial No.

Nitrification Field~~s~~ No Fields 1 Square Feet 1200 Linear Feet 400

No Lines 5 Trench Width 36" Max Trench Bottom Depth 36" Gravel Depth 12"

☒ New System ☐ Repair System Type: I, II, III, IV, V, VI

System Description: gravity conventional

Repair System Description: same

Maintenance Agreement Required: ☐ Yes ☒ No

☒ House/Mod. Home No. Bedrooms 3

☐ Mobile Home No. Bathrooms 2

☐ Business No. Employees

☐ Other


☐ Slab ☒ Crawl Space ☐ Basement w/plumbing ☐ Basement wo/plumbing

Water Supply: ☐ Individual ☒ Community ☐ Public


Comments:

Comments: Tank baffle tee knockout ~~to~~ O.K.
Ditch depth 26" - 18" (upper to lower laterals)
Box set to Feet all equally, but slightly less on lowest lateral.

INITIAL SITE SKETCH

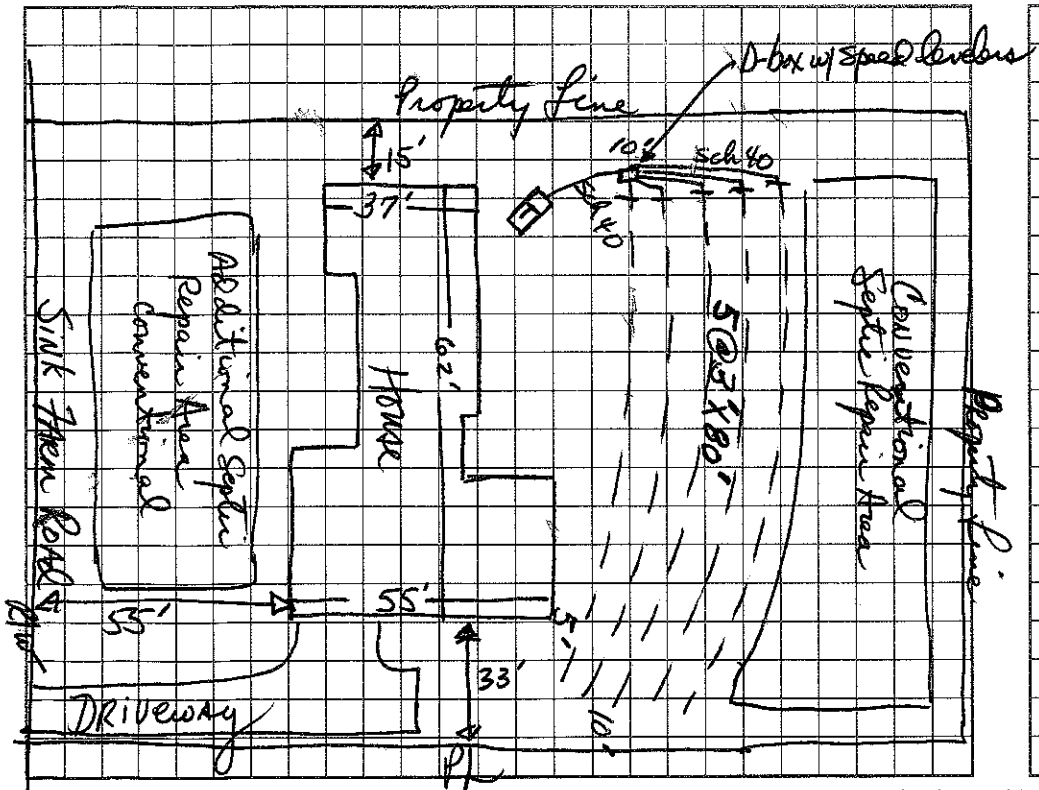

AS BUILT SKETCH

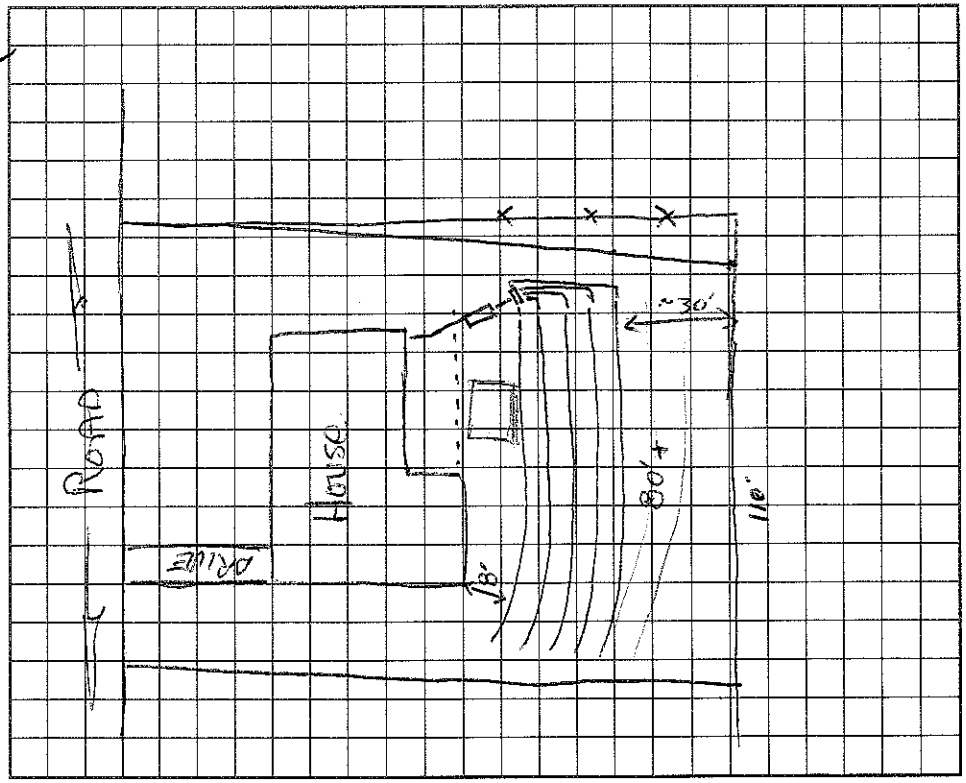

I understand that this permit can be suspended or revoked if any false information is supplied toward securing the permit/any unauthorized changes are made to the site/any unauthorized changes are made in the installation of the system. Improvement Permit is valid for 60 months from ~~date of issuance~~.

Signed: ~~X~~

Improvement Permit by: David R. Hinson RS. date 5/20/94

Existing System Inspection by: date

Installed by: Julian Bowles

Certificate of Completion by: Andrea Lemon date 9-21-94

Operation Permit by: date

HEALTH DEPT. COPY: WHITE INSPECTION COPY (FINAL): GREEN OWNER COPY (FINAL): YELLOW INSPECTION COPY (INITIAL): PINK OWNER COPY (INITIAL): GOLD