11.00

IREDELL COUNTY HEALTH DEPARTMENT

STATESVILLE 704-878-5305 MOORESVILLE 704-664-5281

IMPROVEMENT PERMIT / AUTHORIZATION TO CONSTRUCT / OPERATION PERMIT / EXISTING SYSTEM INSPECTION

PERMIT# 11557 PIN# 4654860952 DATE 5-29-07

OWNER OR APPLICANT Legacy Constructors PHONE: Business 980-297-2787 Home

ADDRESS 4643 Mariner Ln Denver NC 28037

LOCATION 115 S TL Presbyterian TR Sink Farm on left at corner of Buckingham Pl

SUBDIVISION Davidson Downes BLOCK / SECTION 2 LOT 37 LOT AREA .63 Ac SITE CLASS. PS DESIGN FLOW 360gpd L.T.A.R. .3 gpd /ft2

Septic Tank: 1000 Gallons; STB Date

Pump Tank: ~~1000~~ Gallons; PT Date

Pump Make: Model Serial No.

Nitrification Field: No Fields 1 Square Feet 900 Linear Feet 300

No Lines 3 @ 100' Trench Width 36" Max Trench Bottom Depth 36"-40" Gravel Depth NA ☐ Gravity ☒ Pressure

☒ New System ☐ Repair ☐ Expansion System Type: I II (III) IV V VI

System Description: 25% reduction ~~pm~~ Gray

Repair System Description: LP PPBPS

Maintenance Agreement Required: ☐ Yes ☒ No

☒ House/Mod. Home No. Bedrooms 3

☐ Mobile Home No. Persons 6

☐ Business No. Employees

☐ Other


Water Supply: ☐ Individual ☐ Public ☒ Community

☐ Slab ☒ Crawl Space ☐ Basement w/plumbing ☐ Basement wo/plumbing

Comments:/Conditions:

Comments:/Conditions: Installed Quick 4 as shown, able to use Gravity 1/7/08 Checked evaluation, had 5/8 inch fall per foot

INITIAL SITE SKETCH

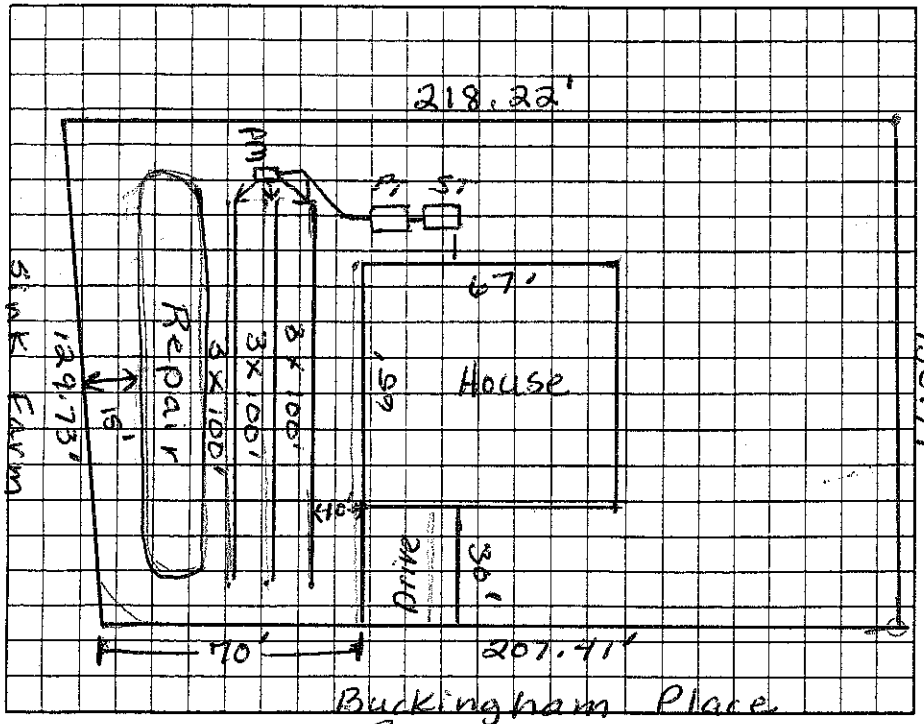

AS BUILT SKETCH

Top line towards Sink Farm ~ 40 inch trench bottom

Permit can be suspended or revoked if any false information is supplied toward securing the permit/any unauthorized changes are made to the site/any unauthorized changes are made in the installation of the system. Improvement Permit with plat valid without expiration ☐ Improvement Permit with site plan valid for sixty months ☒ Authorization to Construct is valid for a period equal to that of Improvement Permit – not to exceed sixty months.

Signed: X date 6-1-07 Installed by: Larry Hinkle RS

Improvement Permit by: Judy McMillan date 5-29-07 Operation Permit by: Mary Ann Dotson date 1/7/08

Authorization to Construct by: Judy McMillan date 5-29-07 Existing System Inspection by: date

HEALTH DEPT. COPY: WHITE OWNER COPY (FINAL): YELLOW OWNER COPY (INITIAL): PINK