930

IREDELL COUNTY HEALTH DEPARTMENT

STATE 704-878-5305 MOORESVILLE 704-664-5281

IMPROVEMENT PERMIT / AUTHORIZATION TO CONSTRUCT / OPERATION PERMIT / EXISTING SYSTEM INSPECTION

PERMIT# 106386 PIN# 4654-86-2639 DATE 6/6/02

OWNER OR CONTRACTOR Bentan Williams Constr PHONE: Business 704-895-3179 Home

ADDRESS 20923 Lakeview Circle Cornelius NC 28031

LOCATION 115 S, TL Presbyterian, TR Sink Farm 2nd Lot East Buckingham on Lt.

SUBDIVISION Davidson Downs BLOCK / SECTION 2 LOT 35 LOT AREA 21,125 ft² SITE CLASS PS DESIGN FLOW 360 L.T.A.R. 0.3

Septic Tank: 1000 Gallons; STB 249 Date 1-20-00
Pump Tank: Gallons; PT Date
Pump Make: Model Serial No.
Nitrification Field: No Fields 1 Square Feet 1200 Linear Feet 400
No Lines 5@80' Trench Width 36" Max Trench Bottom Depth 36" Gravel Depth 12"

☒ New System ☐ Repair System Type: ☐ I ☒ II ☐ III, IV, V, VI
System Description: Gravity Conventional
Repair System Description: Pump 25% Reduction
Maintenance Agreement Required: ☐ Yes ☒ No


☒ House/Mod. Home No. Bedrooms 3
☐ Mobile Home No. Bathrooms 2
☐ Business No. Employees
☐ Other
☐ Slab ☒ Crawl Space ☐ Basement w/plumbing ☐ Basement wo/plumbing

Water Supply:
☐ Individual
☐ Public
☒ Community


Comments/Conditions:

Comments/Conditions: Installed filter

INITIAL SITE SKETCH

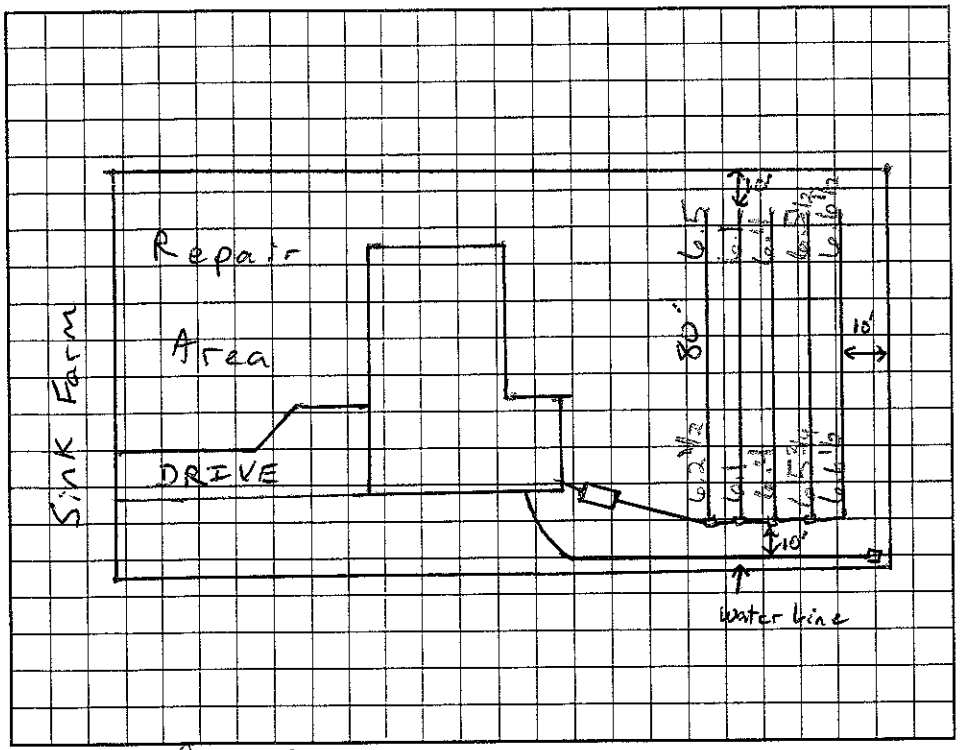

AS BUILT SKETCH

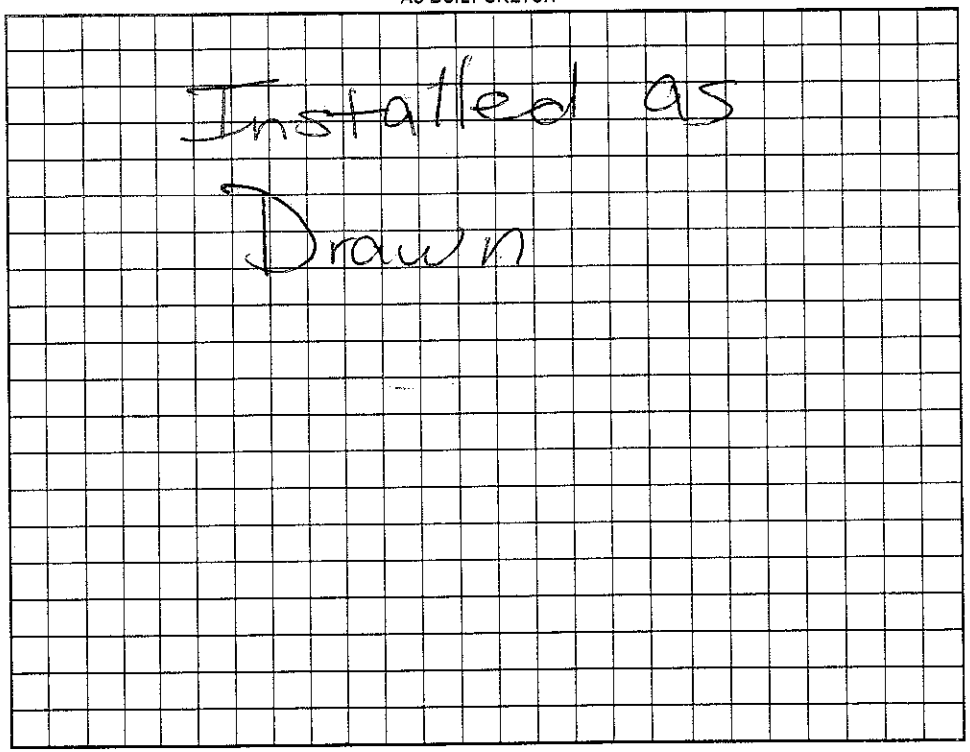

Permit can be suspended or revoked if any false information is supplied toward securing the permit/any unauthorized changes are made to the site/any unauthorized changes are made in the installation of the system. Improvement Permit with plat valid without expiration. Improvement Permit with site plan valid for sixty months. Authorization to Construct is valid for a period equal to that of Improvement Permit – not to exceed sixty months.

Signed: Tony Williams date 6/13/02

Improvement Permit by: RS date 6/6/02

Authorization to Construct by: RS date 6/6/02

Installed by: Claudius Morrison

Operation Permit by: RS date 8/8/2002

Existing System Inspection by: date

HEALTH DEPT. COPY: WHITE OWNER COPY (FINAL): YELLOW OWNER COPY (INITIAL): PINK