IREDELL COUNTY HEALTH DEPARTMENT

STATESVILLE 704-878-5305 MOORESVILLE 704-664-5281

IMPROVEMENT PERMIT / AUTHORIZATION TO CONSTRUCT / OPERATION PERMIT / EXISTING SYSTEM INSPECTION

PERMIT# 079161 PIN# 4654 86 4781 DATE 3/13/99

OWNER OR CONTRACTOR Davidson Downs - Ray Mozley PHONE: Business 892-3747 Home

ADDRESS 269 Canterbury Place Rd. Mooresville, NC. 28115

LOCATION Canterbury Place Rd, 115-215 TL Presbyterian TR Link Farm Rd. TL Buckingham TR Canterbury, 3rd lot on (R)

SUBDIVISION Davidson Downs BLOCK / SECTION LOT 99 LOT AREA .64 AC SITE CLASS. RS DESIGN FLOW 360. L.T.A.R. .3

Septic Tank: 1000 Gallons; STB 760 Date 1-20-99
Pump Tank: 1000 Gallons; PT 189 Date 3/9/99
Pump Make: HYDROMATIK Model SHEF50A1 Serial No. 3/31/99
Nitrification Field: No Fields 1 Square Feet 1200 Linear Feet 400
No Lines 4 Trench Width 36" Max Trench Bottom Depth 32" Gravel Depth 12"

[X] New System [ ] Repair System Type: I, II, (III) IV, V, VI
System Description: Pres. Man - Conventional
Repair System Description: 16" PPBS (FRONT YARD)
Maintenance Agreement Required: [ ] Yes [X] No


[X] House/Mod. Home No. Bedrooms 3
[ ] Mobile Home No. Bathrooms 3
[ ] Business No. Employees
[ ] Other
[ ] Slab [X] Crawl Space [ ] Basement w/plumbing [ ] Basement wo/plumbing

Water Supply: [ ] Individual [ ] Public [X] Community


Comments:/Conditions: 99 Permit - New River and Effluent Filters Required.

Comments:/Conditions:

INITIAL SITE SKETCH

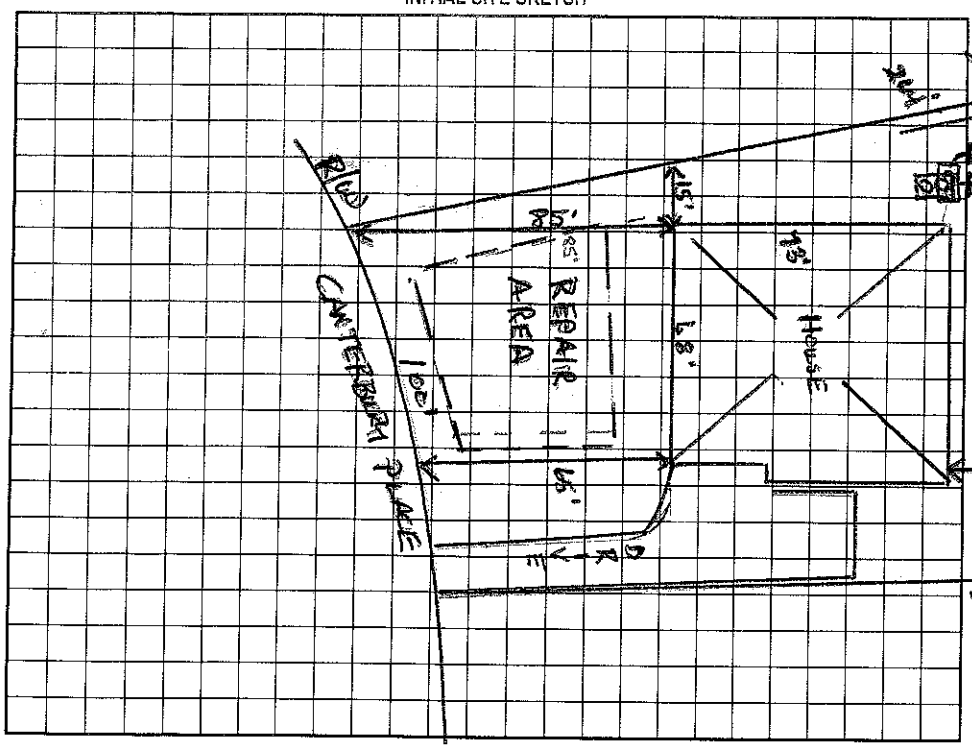

AS BUILT SKETCH

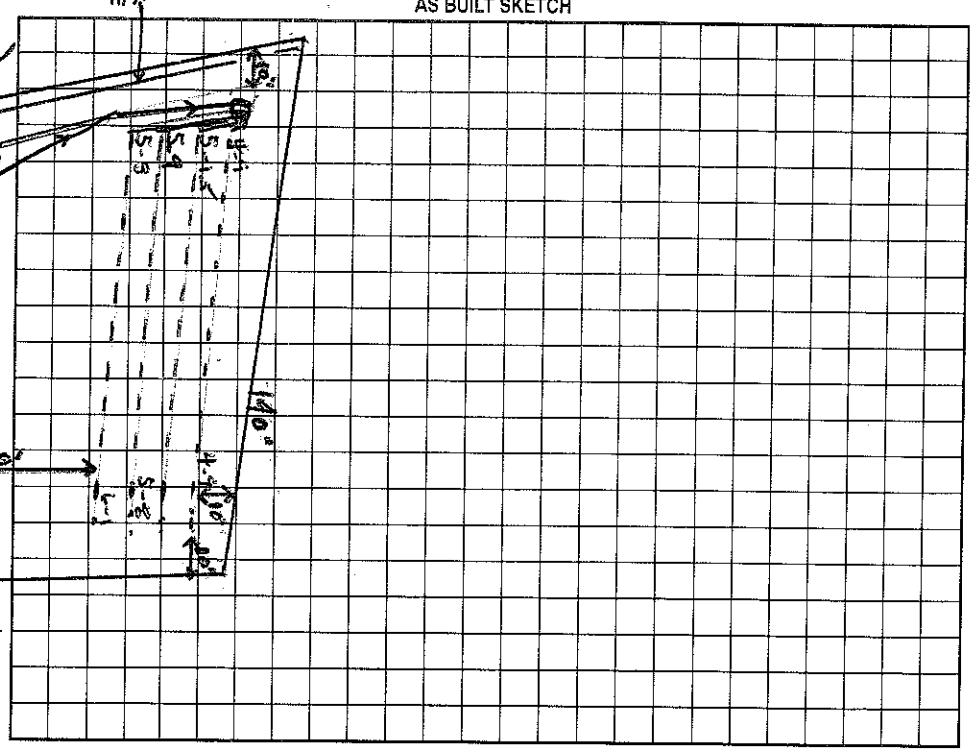

Permit can be suspended or revoked if any false information is supplied toward securing the permit/any unauthorized changes are made to the site/any unauthorized changes are made in the installation of the system. Improvement Permit with plat valid without expiration. Improvement Permit with site plan valid for sixty months. Authorization to Construct is valid for a period equal to that of Improvement Permit – not to exceed sixty months.

Signed: Ray R Mozley date 3-17-99

Improvement Permit by: Wesley Sparks RS. date 3/13/99

Authorization to Construct by: Wesley Sparks RS. date 3/13/99

Installed by: Beginner Const. Co.

Operation Permit by: Wesley Sparks RS. date 9/18/00

Existing System Inspection by: date

HEALTH DEPT. COPY: WHITE OWNER COPY (FINAL): YELLOW OWNER COPY (INITIAL): PINK