2100

IREDELL COUNTY HEALTH DEPARTMENT

STATESVILLE 704-878-5305 MOORESVILLE 704-664-5281

IMPROVEMENT PERMIT / AUTHORIZATION TO CONSTRUCT / OPERATION PERMIT / EXISTING SYSTEM INSPECTION

PERMIT# 133875 PIN# 4654864800 DATE 2-27-06

OWNER OR APPLICANT Legacy Constructors PHONE: Business 704-634-4586 Home 704-483-4864

ADDRESS 4643 Mariner Ln Denver NC 28037

LOCATION 115 South TL Presbyterian TR Sink Farm TL Buckingham TR Canterbury on right (162 Canterbury Pl)

SUBDIVISION Davidson Downes BLOCK / SECTION _____ LOT 100 LOT AREA .47Ac SITE CLASS. PS DESIGN FLOW 360gpd L.T.A.R. .3gpd/ft2

Septic Tank: 1000 Gallons; STB 794 Date 4-30-06
Pump Tank: _____ Gallons; PT _____ Date _____
Pump Make: _____ Model _____ Serial No. _____
Nitrification Field: No Fields 1 Square Feet 1200 Linear Feet 300
No Lines 4 Trench Width 36" Max Trench Bottom Depth 36"

☒ New System ☐ Repair ☐ Expansion System Type: I (II) III IV V VI
System Description: 25% reduction, gravity
Repair System Description: LP Panel
Maintenance Agreement Required: ☐ Yes ☒ No

☒ House/Mod. Home No. Bedrooms 3
☐ Mobile Home No. Persons _____
☐ Business No. Employees _____
☐ Other _____


Water Supply: ☐ Individual ☐ Public ☒ Community

Gravel Depth NA ☒ Gravity ☐ Pressure ☐ Slab ☐ Crawl Space ☐ Basement w/plumbing ☐ Basement wo/plumbing

Comments:/Conditions:
Keep Water line 10' from any part of Repair Area
Keep trench line 25' from storm drain

Comments:/Conditions:

INITIAL SITE SKETCH

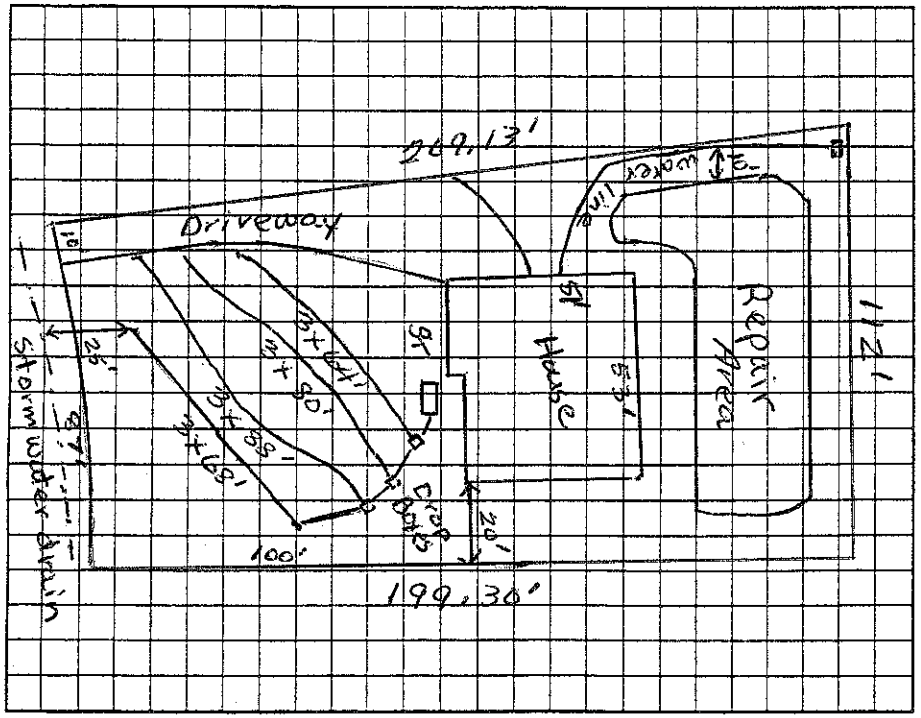

AS BUILT SKETCH

Installed in 4@ 75' Deck 4 Drainfield

Canterbury St.

Permit can be suspended or revoked if any false information is supplied toward securing the permit/any unauthorized changes are made to the site/any unauthorized changes are made in the installation of the system. Improvement Permit with plat valid without expiration ☐ Improvement Permit with site plan valid for sixty months ☒ Authorization to Construct is valid for a period equal to that of Improvement Permit – not to exceed sixty months.

Signed: Wendy Mozeley date 2-28-06
Improvement Permit by: Judy Melville date 2-28-06
Authorization to Construct by: Judy Melville date 2-28-06

Installed by: Larry Hinkle RS
Operation Permit by: Mona Hinkle Dixon date 10/10/06
Existing System Inspection by: _____ date _____

HEALTH DEPT. COPY: WHITE OWNER COPY (FINAL): YELLOW OWNER COPY (INITIAL): PINK