IREDELL COUNTY HEALTH DEPARTMENT

STATESVILLE 704-878-5305 MOORESVILLE 704-664-5281

IMPROVEMENT PERMIT / CERTIFICATE OF COMPLETION / OPERATION PERMIT / EXISTING SYSTEM INSPECTION

PROPERTY DESCRIPTION NO. 17077 DATE 9/27/93 4654868667 TAX MAP NO. 4054 9E 2 24

OWNER OR CONTRACTOR DAVID BUNCH PHONE: Business Home 896-8254

ADDRESS 244 CANTERBURY ST.

LOCATION DEVONSHIRE CT. OFF CANTERBURY

SUBDIVISION DAVIDSON DOWNS BLOCK / SECTION LOT 27 LOT AREA ~27,000 FT² SITE CLASS. P. L.T.A.R. .3

Water Supply: ☐ Individual ☑ Community ☐ Public

Septic Tank: 1000 Gallons; STB Date

Pump Tank: 1000 Gallons; PT Date

Nitrification Field: No Fields 1 Square Feet Linear Feet 210

No Lines 3 Trench Width 2' Trench Depth 32" Gravel Depth SAND

☑ New System ☐ Repair System Type: I, II, II, ⓘ V, VI

System Description: PANEL-LPA DIST.

Repair System Description: SAME

Maintenance Agreement Required: ☑ Yes ☐ No

☑ House/Mod. Home No. Bedrooms 3 Garbage Disposal: ☐ Yes ☑ No

☐ Mobile Home No. Bathrooms 2 Auto. Dishwasher: ☑ Yes ☐ No


☐ Business No. Employees Auto. Washing Machine: ☑ Yes ☐ No

☐ Other Other

☐ Slab ☑ Crawl Space ☑ Basement w/plumbing ☐ Basement wo/plumbing

Comments MAINTENANCE AGREEMENT REQUIRED.
LPP - PANEL SYSTEM.

INITIAL SITE SKETCH

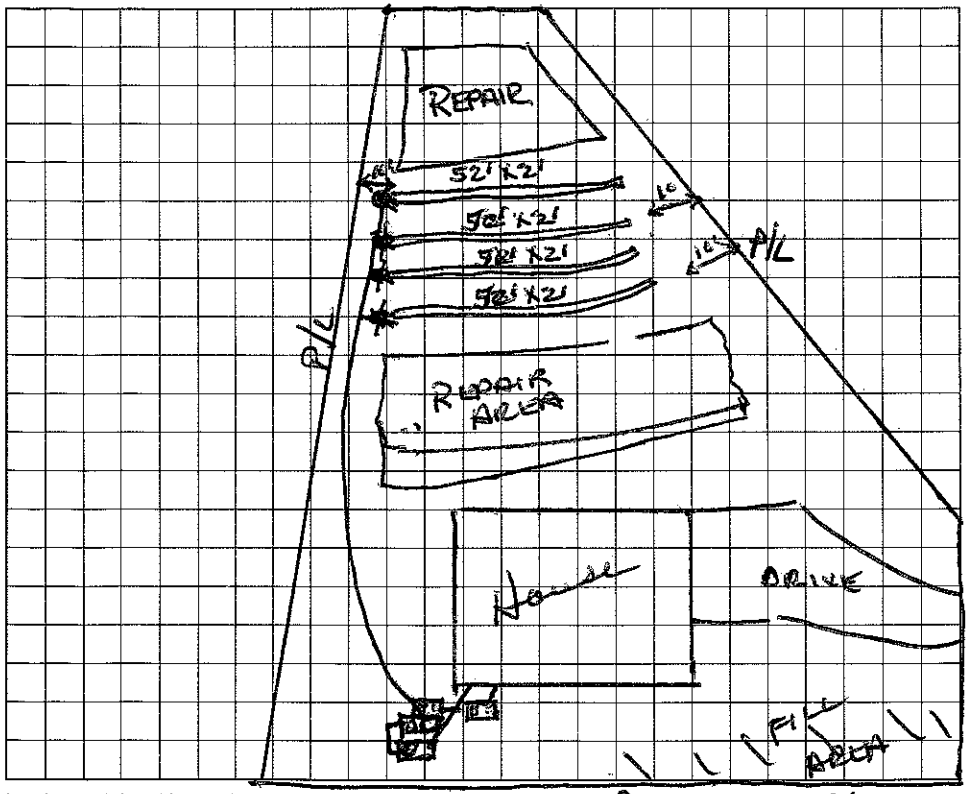

AS BUILT SKETCH

Installed as shown.
4/20/94

I understand that this permit can be suspended or revoked if any false information is supplied toward securing the permit/any unauthorized changes are made to the site/any unauthorized changes are made in the installation of the system. Improvement Permit is valid for 60 months from date of issuance.

Signed: ~~Wesley Sparks RS~~ Bill Hudson

Improvement Permit by: Wesley Sparks RS. date 9/27/93

Existing System Inspection by: date

Installed by: Dobson Const. Co.

Certificate of Completion by: Wesley Sparks RS date 4/20/94

Operation Permit by: date

HEALTH DEPT. COPY: WHITE INSPECTION COPY (FINAL): GREEN OWNER COPY (FINAL): YELLOW INSPECTION COPY (INITIAL): PINK OWNER COPY (INITIAL): GOLD

