IREDELL COUNTY HEALTH DEPARTMENT

STATESVILLE 704-878-5305 MOORESVILLE 704-664-5281

IMPROVEMENT PERMIT / AUTHORIZATION TO CONSTRUCT / OPERATION PERMIT / EXISTING SYSTEM INSPECTION

PERMIT# 086321 PIN# 4654 87 1174 DATE 12/6/99

OWNER OR CONTRACTOR Ray Mozeley - Davidson Downes PHONE: Business 892-3747 Home

ADDRESS 267 Canterbury Pl. Mooresville, NC. 28115

LOCATION 1155 TL Presbyterian Rd. TR Sink Farm TL Buckingham Pl TL Canterbury Place, to 2nd lot on (L)

SUBDIVISION DAVIDSON DOWNES BLOCK / SECTION LOT 193 LOT AREA 1.0 Ac SITE CLASS. PS DESIGN FLOW 360 L.T.A.R. .3

Septic Tank: 1000 Gallons; STB 794 Date 2/28/01
Pump Tank: Gallons; PT Date
Pump Make: Model Serial No.
Nitrification Field: No Fields 1 Square Feet 1200 Linear Feet 400
No Lines 5 Trench Width 36" Max Trench Bottom Depth 36" Gravel Depth 12"

☒ New System ☐ Repair System Type: I (II) III, IV, V, VI
System Description: Gravity - Conventional
Repair System Description: Pressure 16" PPBS
Maintenance Agreement Required: ☐ Yes ☒ No


☒ House/Mod. Home No. Bedrooms 3
☐ Mobile Home No. Bathrooms 3
☐ Business No. Employees
☐ Other
☐ Slab ☒ Crawl Space ☐ Basement w/plumbing ☐ Basement wo/plumbing

Water Supply:
☐ Individual
☐ Public
☒ Community


Comments:/Conditions:

Comments:/Conditions:
installed as shown.

INITIAL SITE SKETCH (1"=40')

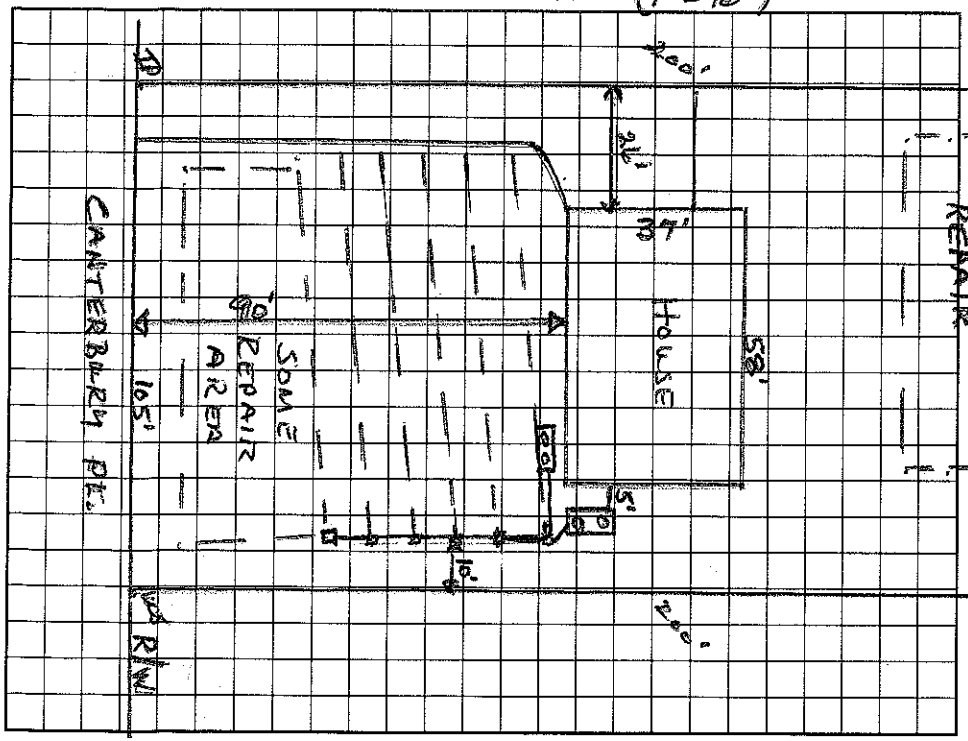

AS BUILT SKETCH

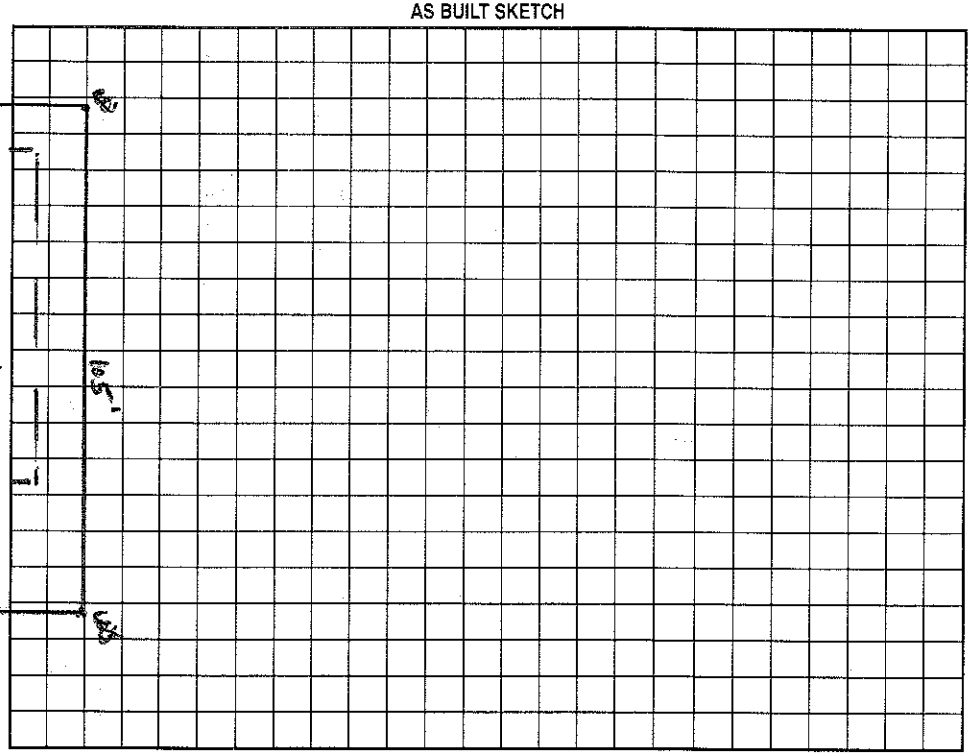

Permit can be suspended or revoked if any false information is supplied toward securing the permit/any unauthorized changes are made to the site/any unauthorized changes are made in the installation of the system. Improvement Permit with plat valid without expiration. Improvement Permit with site plan valid for sixty months. Authorization to Construct is valid for a period equal to that of Improvement Permit – not to exceed sixty months.

Signed: Ray Mozeley date 12/14/99 Installed by: Curt Denning

Improvement Permit by: Wesley Sparks R.S. date 12/6/99 Operation Permit by: Wesley Sparks R.S. date 4/24/01

Authorization to Construct by: Wesley Sparks R.S. date 12-6-99 Existing System Inspection by: date

HEALTH DEPT. COPY: WHITE OWNER COPY (FINAL): YELLOW OWNER COPY (INITIAL): PINK