IREDELL COUNTY HEALTH DEPARTMENT

STATESVILLE 704-878-5305 MOORESVILLE 704-664-5281

IMPROVEMENT PERMIT / AUTHORIZATION TO CONSTRUCT / OPERATION PERMIT / EXISTING SYSTEM INSPECTION

PERMIT # 115610 PIN # 4654 87 3239 DATE 7/20/09

OWNER or APPLICANT LEGACY CONSTRUCTORS PHONE: Business 980-297-2787 Home:

OWNER or APPLICANT ADDRESS 4643 MARINER LN. DENVER, NC. 28037

LOCATION / DIRECTIONS 143 CANTERBURY PL R/115 S TL PRESBYTERIAN TR SINK FARM TL BUCKINGHAM TL CANTERBURY, 2ND ON R

SUBDIVISION DAVIDSON DOWNS BLOCK / SECTION LOT # 73 LOT AREA ~.52AC DESIGN FLOW 360 L.T.A.R. .3

Septic Tank 1000 Gallons: STB Date

Pump Tank 1000 Gallons: P T Date

Pump Make Model Serial #

Nitrification Field No Fields No Lines 3 Linear Feet 240

Trench Width 3' Max. Trench Bottom Depth 3' Gravel Depth NO

☒ New System ☐ Repair ☐ Expansion System Type I II III (IV) V VI

System Description: LP - 16" PPBRS

Repair System Description: SAME

Maintenance Agreement Required ☒ YES ☐ NO

☐ GRAVITY ☒ PRESSURE

☒ Residence No. Bedrooms 3

☐ Business No. Persons

☐ Other No. Employees

☐ Slab ☐ Crawl Space

☐ Basement w/plumbing ☒ Basement w/o plumbing

Water Supply: ☐ Private ☐ Public ☒ Community

Comments / Conditions


INITIAL SITE SKETCH

Comments / Conditions

130'

~1" = 40'

AS BUILT SKETCH

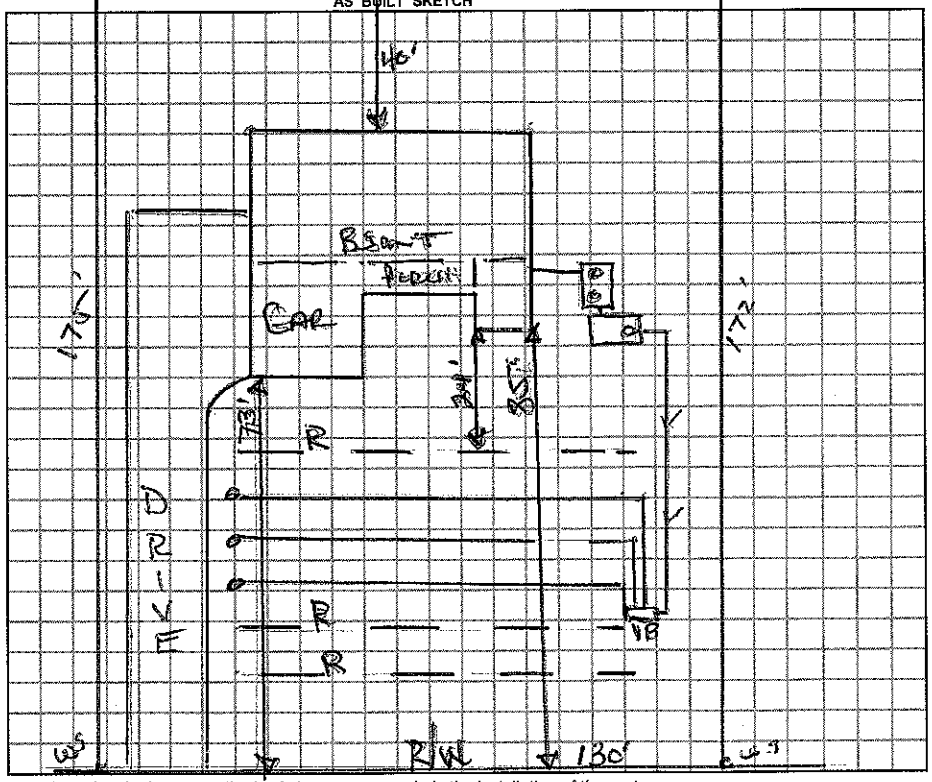

Permit can be suspended or revoked if any false information is supplied toward securing the permit / any unauthorized changes are made to the site / any unauthorized changes are made in the installation of the system.

☐ *IMPROVEMENT PERMIT w / plat valid without expiration.* ☐ *IMPROVEMENT PERMIT w / site plan valid for 60 mos.* ☐ *AUTHORIZATION TO CONSTRUCT valid for period equal to IMPROVEMENT PERMIT-not to exceed 60 mo.*

Owner / Applicant Signature: Wendy Mozely Date 7/21/09

Improvement Permit by: Date

Authorization to Construct by: Date

YOU SHOULD CONTACT A LOCATOR SERVICE PRIOR TO ANY EXCAVATION.

Installed by: CANTERBURY PLACE

Operation Permit by: Date:

Existing System Inspected by: Wesley Sparks RS Date: 7/20/09

WHITE COPY Environmental Health YELLOW COPY (Final) Owner / Applicant PINK COPY (Initial) Owner / Applicant