IRED[illegible] COUNTY HEALTH DEPARTMENT

STATESVILLE 704-878-5305 MOORESVILLE 704-664-5281

IMPROVEMENT PERMIT / AUTHORIZATION TO CONSTRUCT / OPERATION PERMIT / EXISTING SYSTEM INSPECTION

PERMIT# 115610 PIN# 4654 87 3239 DATE 9/6/07

OWNER OR APPLICANT Legacy Constructors PHONE: Business 980-297-2787 Home

ADDRESS 4643 Mariner Ln. Denver, NC. 28037

LOCATION 1155 TL Presbyterian TR Sink Farm TL on Buckingham TL Canterbury 2nd lot on (R)

SUBDIVISION DAVIDSON DOWNS BLOCK / SECTION LOT 73 LOT AREA .52AC SITE CLASS PS I DESIGN FLOW 360 L.T.A.R. .3

Septic Tank: 1000 Gallons: STB 794 Date 11/19/98

Pump Tank: 1000 Gallons: PT 293 Date 5/2/04

Pump Make: Cowans Model WE0-712M Serial No.

Nitrification Field: No Fields 1 Square Feet 720 Linear Feet 240

No Lines 3@80' Trench Width 2-3' Max Trench Bottom Depth 3'

☒ New System ☐ Repair ☐ Expansion System Type: I II III (IV) V VI

System Description: PressDosed - 16" PPBPS

Repair System Description: Same Type

Maintenance Agreement Required: ☒ Yes ☐ No

☒ House/Mod. Home ☐ Mobile Home ☐ Business ☐ Other

No. Bedrooms 3 No. Persons No. Employees


Water Supply: ☐ Individual ☐ Public ☒ Community

Gravel Depth No ☐ Gravity ☒ Pressure ☐ Slab ☒ Crawl Space ☐ Basement w/plumbing ☐ Basement wo/plumbing

Comments:/Conditions:

Comments:/Conditions: 3.5' - 5/32" HOLES

INITIAL SITE SKETCH

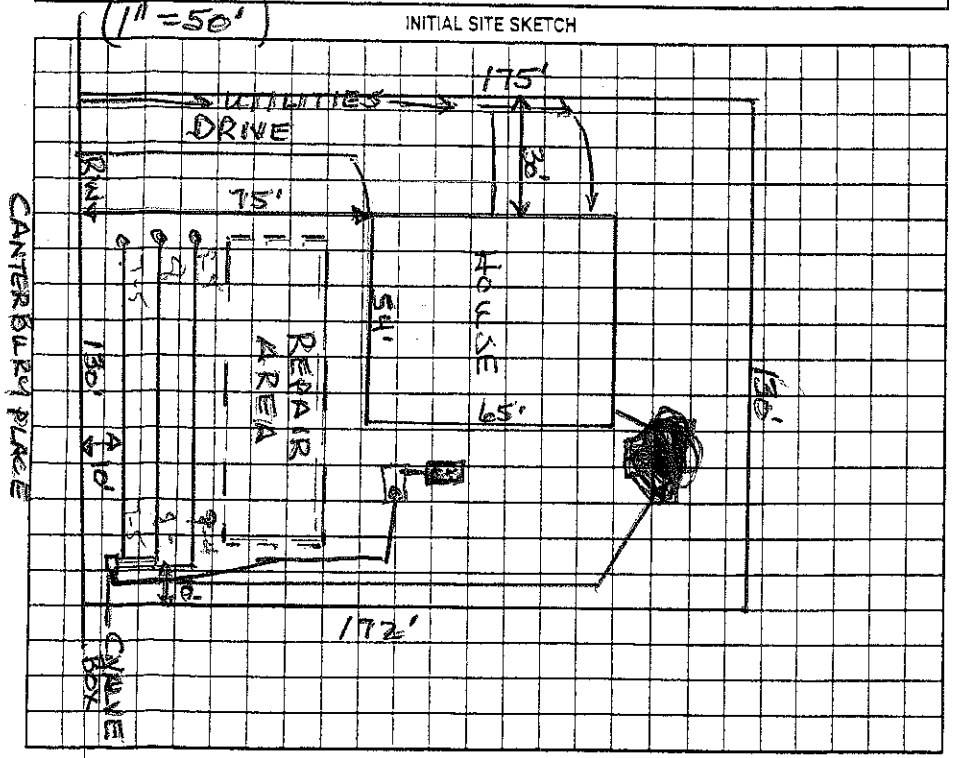

AS BUILT SKETCH

Permit can be suspended or revoked if any false information is supplied toward securing the permit/any unauthorized changes are made to the site/any unauthorized changes are made in the installation of the system. Improvement Permit with plat valid without expiration ☐ Improvement Permit with site plan valid for sixty months ☐ Authorization to Construct is valid for a period equal to that of Improvement Permit – not to exceed sixty months.

Signed: [signature] date 10-3-07 Installed by: F J Ervin

Improvement Permit by: Wesley Sparks RS. date 9/6/07 Operation Permit by: Wesley Sparks RS. date 8/14/08

Authorization to Construct by: Wesley Sparks RS date 9/6/07 Existing System Inspection by: date

HEALTH DEPT. COPY: WHITE OWNER COPY (FINAL): YELLOW OWNER COPY (INITIAL): PINK