PIN# 4654-87-4416

(2:00)

IREDELL COUNTY HEALTH DEPARTMENT

AUTHORIZATION TO CONSTRUCT

STATESVILLE 704-878-5305 MOORESVILLE 704-664-5281

IMPROVEMENT PERMIT / ~~CERTIFICATE OF COMPLETION~~ / OPERATION PERMIT / EXISTING SYSTEM INSPECTION

PROPERTY DESCRIPTION NO. 17441 DATE 10/2/96 TAX MAP NO. 1C-2-A-75 Watershed: ☐ Yes ☐ No

OWNER OR CONTRACTOR JEFF MAREK PHONE: Business _____ Home 996-9509

ADDRESS 1995-C HENDERSON Rd - DAVIDSON NC 28036

LOCATION 1155 TL PRESBYTERIAN CH TO BUCKINGHAM TO CANTERBERY TL YORKSHIRE ON RT AT END

SUBDIVISION DAVIDSON DOWNES BLOCK / SECTION _____ LOT 75 LOT AREA _____ SITE CLASS. CS DESIGN FLOW 300GPD L.T.A.R. .36 AD/FT²

Septic Tank: 1000 Gallons; STB 704 Date 4/29/97

Pump Tank: _____ Gallons; PT _____ Date _____

Pump Make: _____ Model _____ Serial No. _____

Nitrification Field: No Fields 1 Square Feet 400 Linear Feet 200

No Lines 4 Trench Width 24" Max Trench Bottom Depth 36" Gravel Depth N/A

☑ New System ☐ Repair System Type: I, II, (III), IV, V, VI

System Description: GRAVITY ~~CHAMBER~~ PANEL

Repair System Description: PUMP PANEL

Maintenance Agreement Required: ☐ Yes ☑ No

☑ House/Mod. Home No. Bedrooms 3

☐ Mobile Home No. Bathrooms 2

☐ Business No. Employees _____

☐ Other _____


☐ Slab ☑ Crawl Space ☐ Basement w/plumbing ☐ Basement wo/plumbing

Water Supply: ☑ Individual ☐ Community ☐ Public


Comments:

Comments:

INITIAL SITE SKETCH

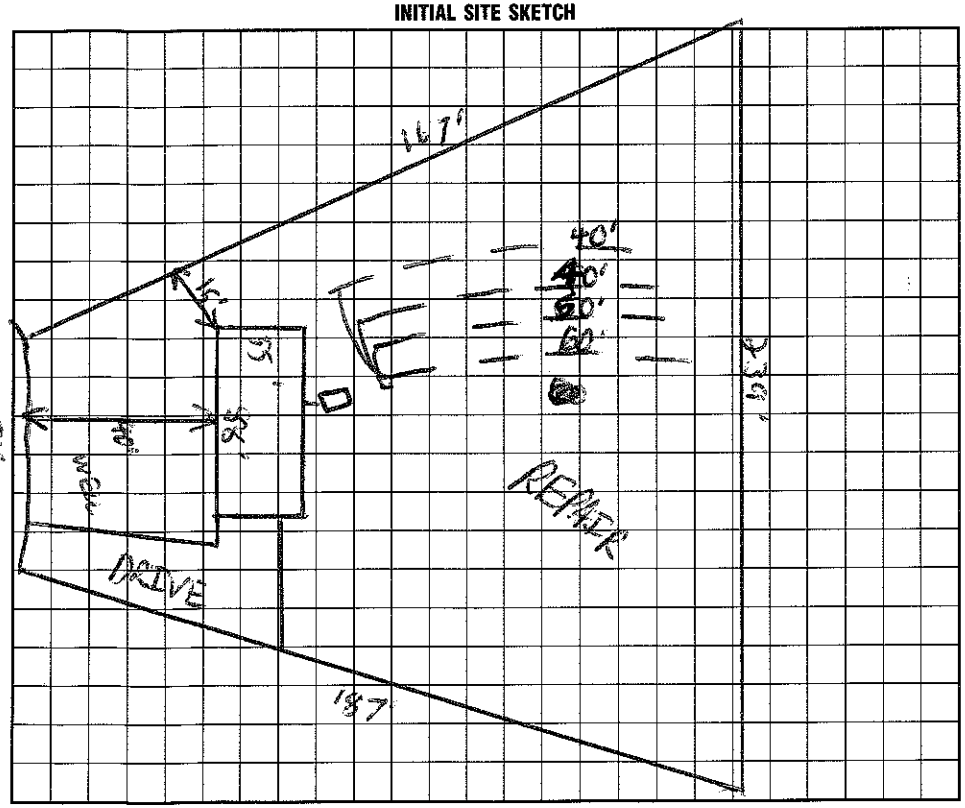

AS BUILT SKETCH

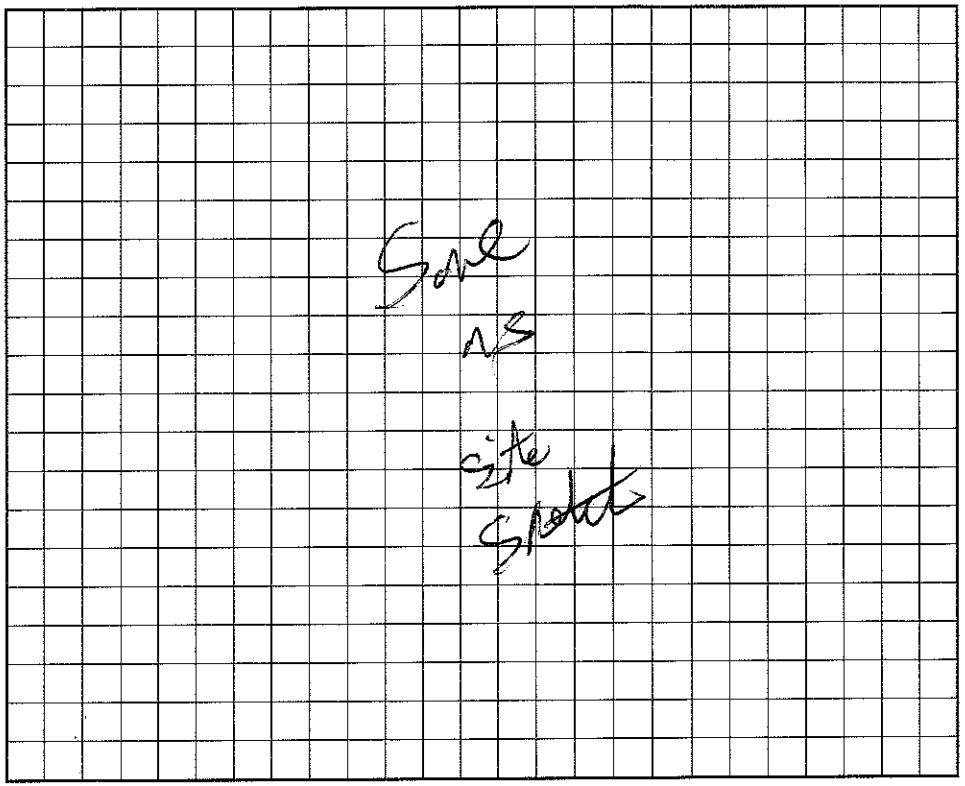

I understand that this permit can be suspended or revoked if any false information is supplied toward securing the permit/any unauthorized changes are made to the site/any unauthorized changes are made in the installation of the system.

Signed: Jeffrey E. Marek

Installed by: ORBISON

Improvement Permit by: C. Blackstone EHSI date 10/2/96

Certificate of Completion by: _____ date _____

~~Existing System Inspection by:~~ AUTHORIZATION TO CONSTRUCT C. Blackstone EHSI date 10/2/96

Operation Permit by: _____ date 7/16/97

HEALTH DEPT. COPY: WHITE INSPECTION COPY (FINAL): GREEN OWNER COPY (FINAL): YELLOW INSPECTION COPY (INITIAL): PINK OWNER COPY (INITIAL): GOLD