IREDELL COUNTY HEALTH DEPARTMENT

Authorization to Construct — Paul Barry - 662-0649, 515-9904

STATESVILLE 704-878-5305 — MOORESVILLE 704-664-5281

IMPROVEMENT PERMIT / ~~CERTIFICATE OF COMPLETION~~ / OPERATION PERMIT / EXISTING SYSTEM INSPECTION

PROPERTY DESCRIPTION NO. 25455 DATE 12/9/96 TAX MAP NO. TC 2A 81

OWNER OR CONTRACTOR Ray Moseley PHONE: Business 892-3747 Home 4654-87-5012 Watershed: ☐ Yes ☒ No

ADDRESS 218 Canterbury Pl Mooresville, NC. 28115

LOCATION 1155 TL Presley Rd. TR Sink Farm TL Buckingham TR Canterbury (L) corner lot

SUBDIVISION Davidson Downs BLOCK / SECTION ____ LOT 81 LOT AREA .63AC SITE CLASS. PS DESIGN FLOW 360 L.T.A.R. .25

Septic Tank: 1000 Gallons; STB 1012 Date 9/14/99

Pump Tank: 1000 Gallons; PT 17 Date 3/25/99

Pump Make: Gould Model ____ Serial No. ____

Nitrification Field: No Fields 1 Square Feet 480* Linear Feet 240*

No Lines 3 Trench Width 24" Max Trench Bottom Depth 30" Gravel Depth SAND.

☒ New System ☐ Repair System Type: I, II, (III), IV, V, VI

System Description: * 16" PBPS/Pressure

Repair System Description: * Same

Maintenance Agreement Required: ☐ Yes ☒ No

☒ House/Mod. Home ☐ Mobile Home ☐ Business ☐ Other

No. Bedrooms 3 No. Bathrooms 2 No. Employees ____

☐ Slab ☐ Crawl Space ☒ Basement w/plumbing ☐ Basement wo/plumbing


Water Supply: ☐ Individual ☒ Community ☐ Public

Comments:

Comments:

LOT 81 NO LONGER EXISTS

INITIAL SITE SKETCH

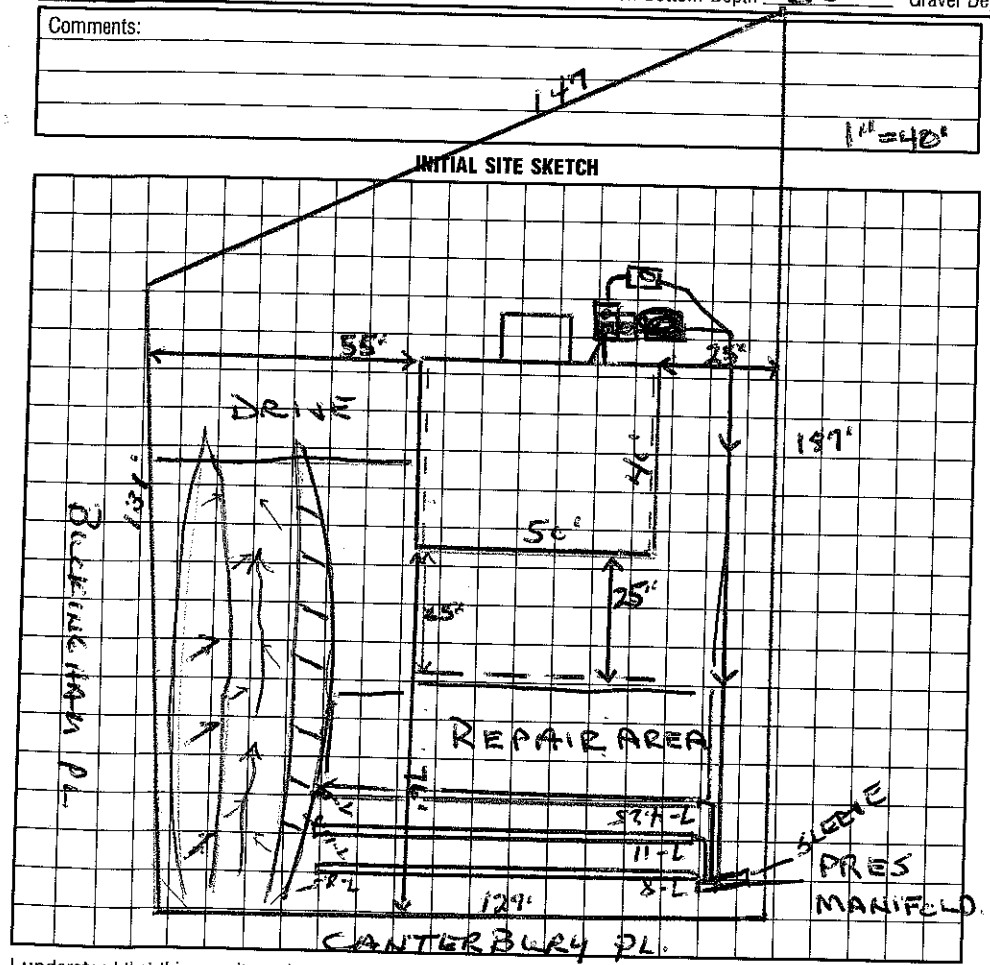

AS BUILT SKETCH

I understand that this permit can be suspended or revoked if any false information is supplied toward securing the permit/any unauthorized changes are made to the site/any unauthorized changes are made in the installation of the system.

Signed: * Ray Moseley

Improvement Permit by: Wesley Sparks R.S. date 12/9/96

Existing System Inspection by: Wesley Sparks R.S. date 12/9/96

Installed by: Forest Shuford

Certificate of Completion by: ____ date ____

Operation Permit by: Wesley Sparks R.S. date 8/2/00

HEALTH DEPT. COPY: WHITE — INSPECTION COPY (FINAL): GREEN — OWNER COPY (FINAL): YELLOW — INSPECTION COPY (INITIAL): PINK — OWNER COPY (INITIAL): GOLD