PIN# 4654-87-5456

# IREDELL COUNTY HEALTH DEPARTMENT

Authorization to Construct

(1.00)

STATESVILLE 704-878-5305 MOORESVILLE 704-664-5281

## IMPROVEMENT PERMIT / ~~CERTIFICATE OF COMPLETION~~ / OPERATION PERMIT / EXISTING SYSTEM INSPE

PROPERTY DESCRIPTION NO. 25541 DATE 12/9/96 TAX MAP NO. 1C 2 A 81 Watershed: ☐ Yes ☒ No

OWNER OR CONTRACTOR John Elliott PHONE: Business 896-7671 Home

ADDRESS 18741-304 Nautical Dr. Cornelius NC 28031

LOCATION 1155 TL Presbyterian Rd. TR Sink Farm TL Buckingham, 2nd on left after crossing Centelenny Pl

SUBDIVISION Davidson Downs BLOCK / SECTION LOT 70 LOT AREA .62AC SITE CLASS. PS DESIGN FLOW 360 L.T.A.R. .3

Septic Tank: 1000 Gallons; STB 797 Date 9/20/97

Pump Tank: Gallons; PT Date

Pump Make: Model Serial No. 300 LF

Nitrification Field: No Fields 1 Square Feet ~~900~~ Linear Feet ~~300~~

No Lines 3 Trench Width 36" Max Trench Bottom Depth 30 Gravel Depth SAND

☒ New System ☐ Repair System Type: I, II, III, IV, V, VI

System Description: ~~HW PPBAS - DIST BOX~~

Repair System Description: Pressure Panel

Maintenance Agreement Required: ☐ Yes ☒ No

☒ House/Mod. Home No. Bedrooms 3

☐ Mobile Home No. Bathrooms 2


☐ Business No. Employees

☐ Other

☐ Slab ☒ Crawl Space ☐ Basement w/plumbing ☐ Basement wo/plumbing

Water Supply: ☐ Individual ☒ Community ☐ Public

Comments: 176'

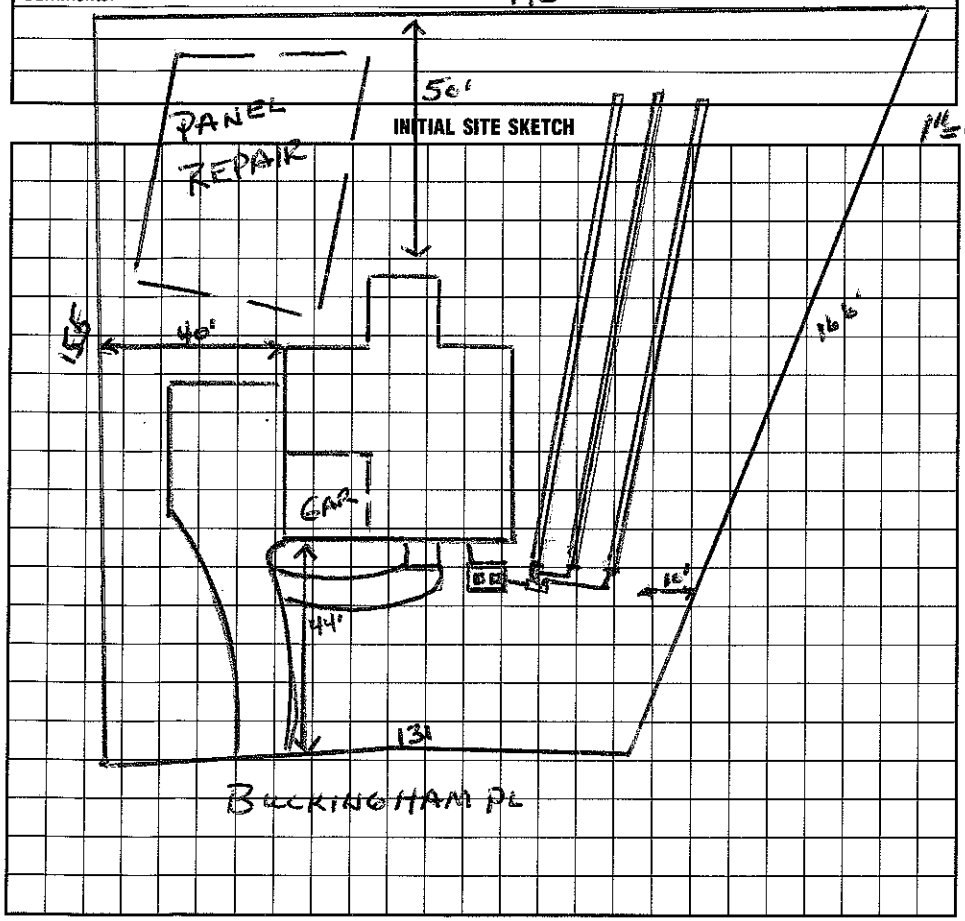


Comments: ~~300~~ FT CH. PLASTIC DRAINLINE

installed as shown on Auth. Permit

AS BUILT SKETCH

I understand that this permit can be suspended or revoked if any false information is supplied toward securing the permit/any unauthorized changes are made to the site/any unauthorized changes are made in the installation of the system.

Signed: ~~X~~ Ray Moore

Improvement Permit by: Wesley Sparks R.S. date 12/9/96

~~Existing~~ System Inspection by: Wesley Sparks R.S. date 12/9/96

Installed by: F J Erwin

Certificate of Completion by: Wesley Sparks R.S. date 11/18/97

Operation Permit by: Wesley Sparks R.S. date 11/18/97

Health

HEALTH DEPT. COPY: WHITE INSPECTION COPY (FINAL): GREEN OWNER COPY (FINAL): YELLOW INSPECTION COPY (INITIAL): PINK OWNER COPY (INITIAL): GOLD