IREDELL COUNTY HEALTH DEPARTMENT


ENVIRONMENTAL HEALTH DIVISION

PAGE 2: *SITE PLAN WORKSHEET*

SEE THE "SAMPLE SITE PLAN" BELOW. *INCOMPLETE SITE PLANS WILL BE RETURNED TO YOU FOR COMPLETION AND MAY RESULT IN A DELAY IN THE ISSUANCE OF YOUR SEPTIC SYSTEM PERMIT!!!*

Place an (X) beside each item as you complete the site plan:

- (X) Property Line measurements are clearly identified
- (X) All proposed structures are indicated
- (X) Front and side setbacks from property line
- (X) Preferred driveway location and well location
- (X) Area you prefer your septic system to be placed
- (X) North arrow, or other sufficient indicator of direction

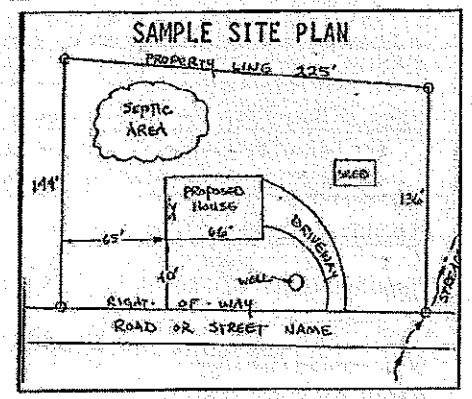


Circle N/A on the following if appropriate:

Location of septic systems and wells within 100' of your property	N/A
Location of easements and rights of ways on your property	N/A
Location of any designated wetlands on the property	N/A

USE THIS SPACE TO DRAW YOUR SITE PLAN

Show: proposed house or business footprint, wells, water lines, patios, pools and decks, and any other item that will occupy space on the site

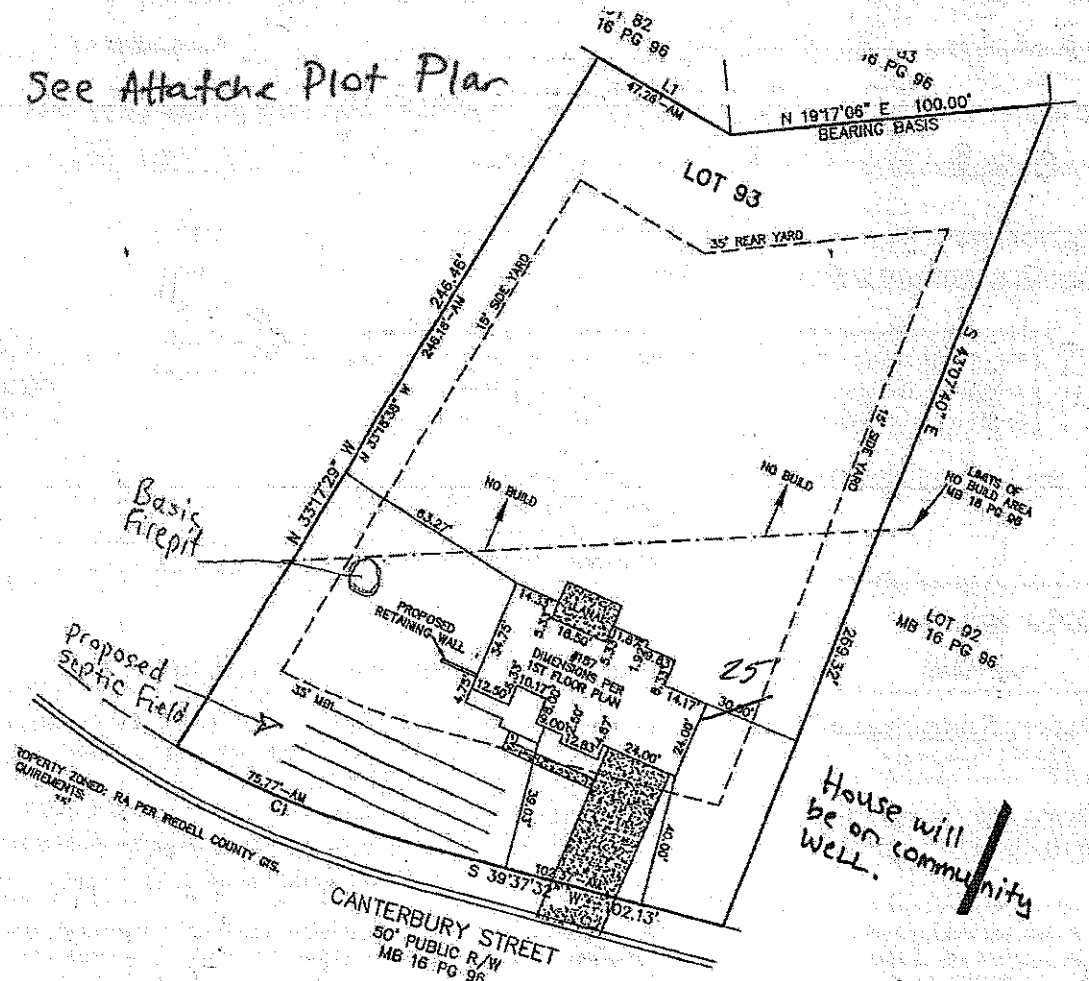

Signature: Bonnie T. Burton

Property owner or owner's legal representative signature (SIGNATURE REQUIRED)

4/8/15

DATE

STATESVILLE 704-878-5305 MOORESVILLE 704-664-5281

IMPROVEMENT PERMIT / AUTHORIZATION TO CONSTRUCT / OPERATION PERMIT / EXISTING SYSTEM INSPECTI[ON]

PERMIT# 081198 PIN# 4654 87 9001

OWNER OR CONTRACTOR Davidson Downs DATE 6/4/99

ADDRESS 218 Canterbury Place Mooresville, NC 28115 PHONE: Business 892-3747 Home

LOCATION 1155 TL Presbyterian Rd. TR Sink Farm, TL Buckingham TR Canterbury to 5th lot on (L)

SUBDIVISION DAVIDSON DOWNES BLOCK / SECTION LOT 93 LOT AREA .73AC. SITE CLASS. PS DESIGN FLOW 360 L.T.A.R. .3

Septic Tank: 1000 Gallons; STB Date

Pump Tank: 1000 Gallons; PT Date

Pump Make: Model Serial No.

Nitrification Field: No Fields 1 Square Feet 900 Linear Feet 300

No Lines 4 Trench Width 36" Max Trench Bottom Depth 36" Gravel Depth 36ND

[X] New System ☐ Repair System Type: I, II, (III) IV, V, VI

System Description: Pres Man to Ch Plastic on H.O.S.

Repair System Description: 16" Pressure Panel 16"

Maintenance Agreement Required: ☐ Yes [X] No

☐ Slab ☐ Crawl Space [X] Basement w/plumbing ☐ Basement wo/plumbing

[X] House/Mod. Home No. Bedrooms 3

☐ Mobile Home No. Bathrooms 2

☐ Business No. Employees


☐ Other

Water Supp[ly]: ☐ Individua[l] ☐ Public [X] Commun[ity]

Comments/Conditions:

Comments/Conditions:

INITIAL SITE SKETCH 250 / 180

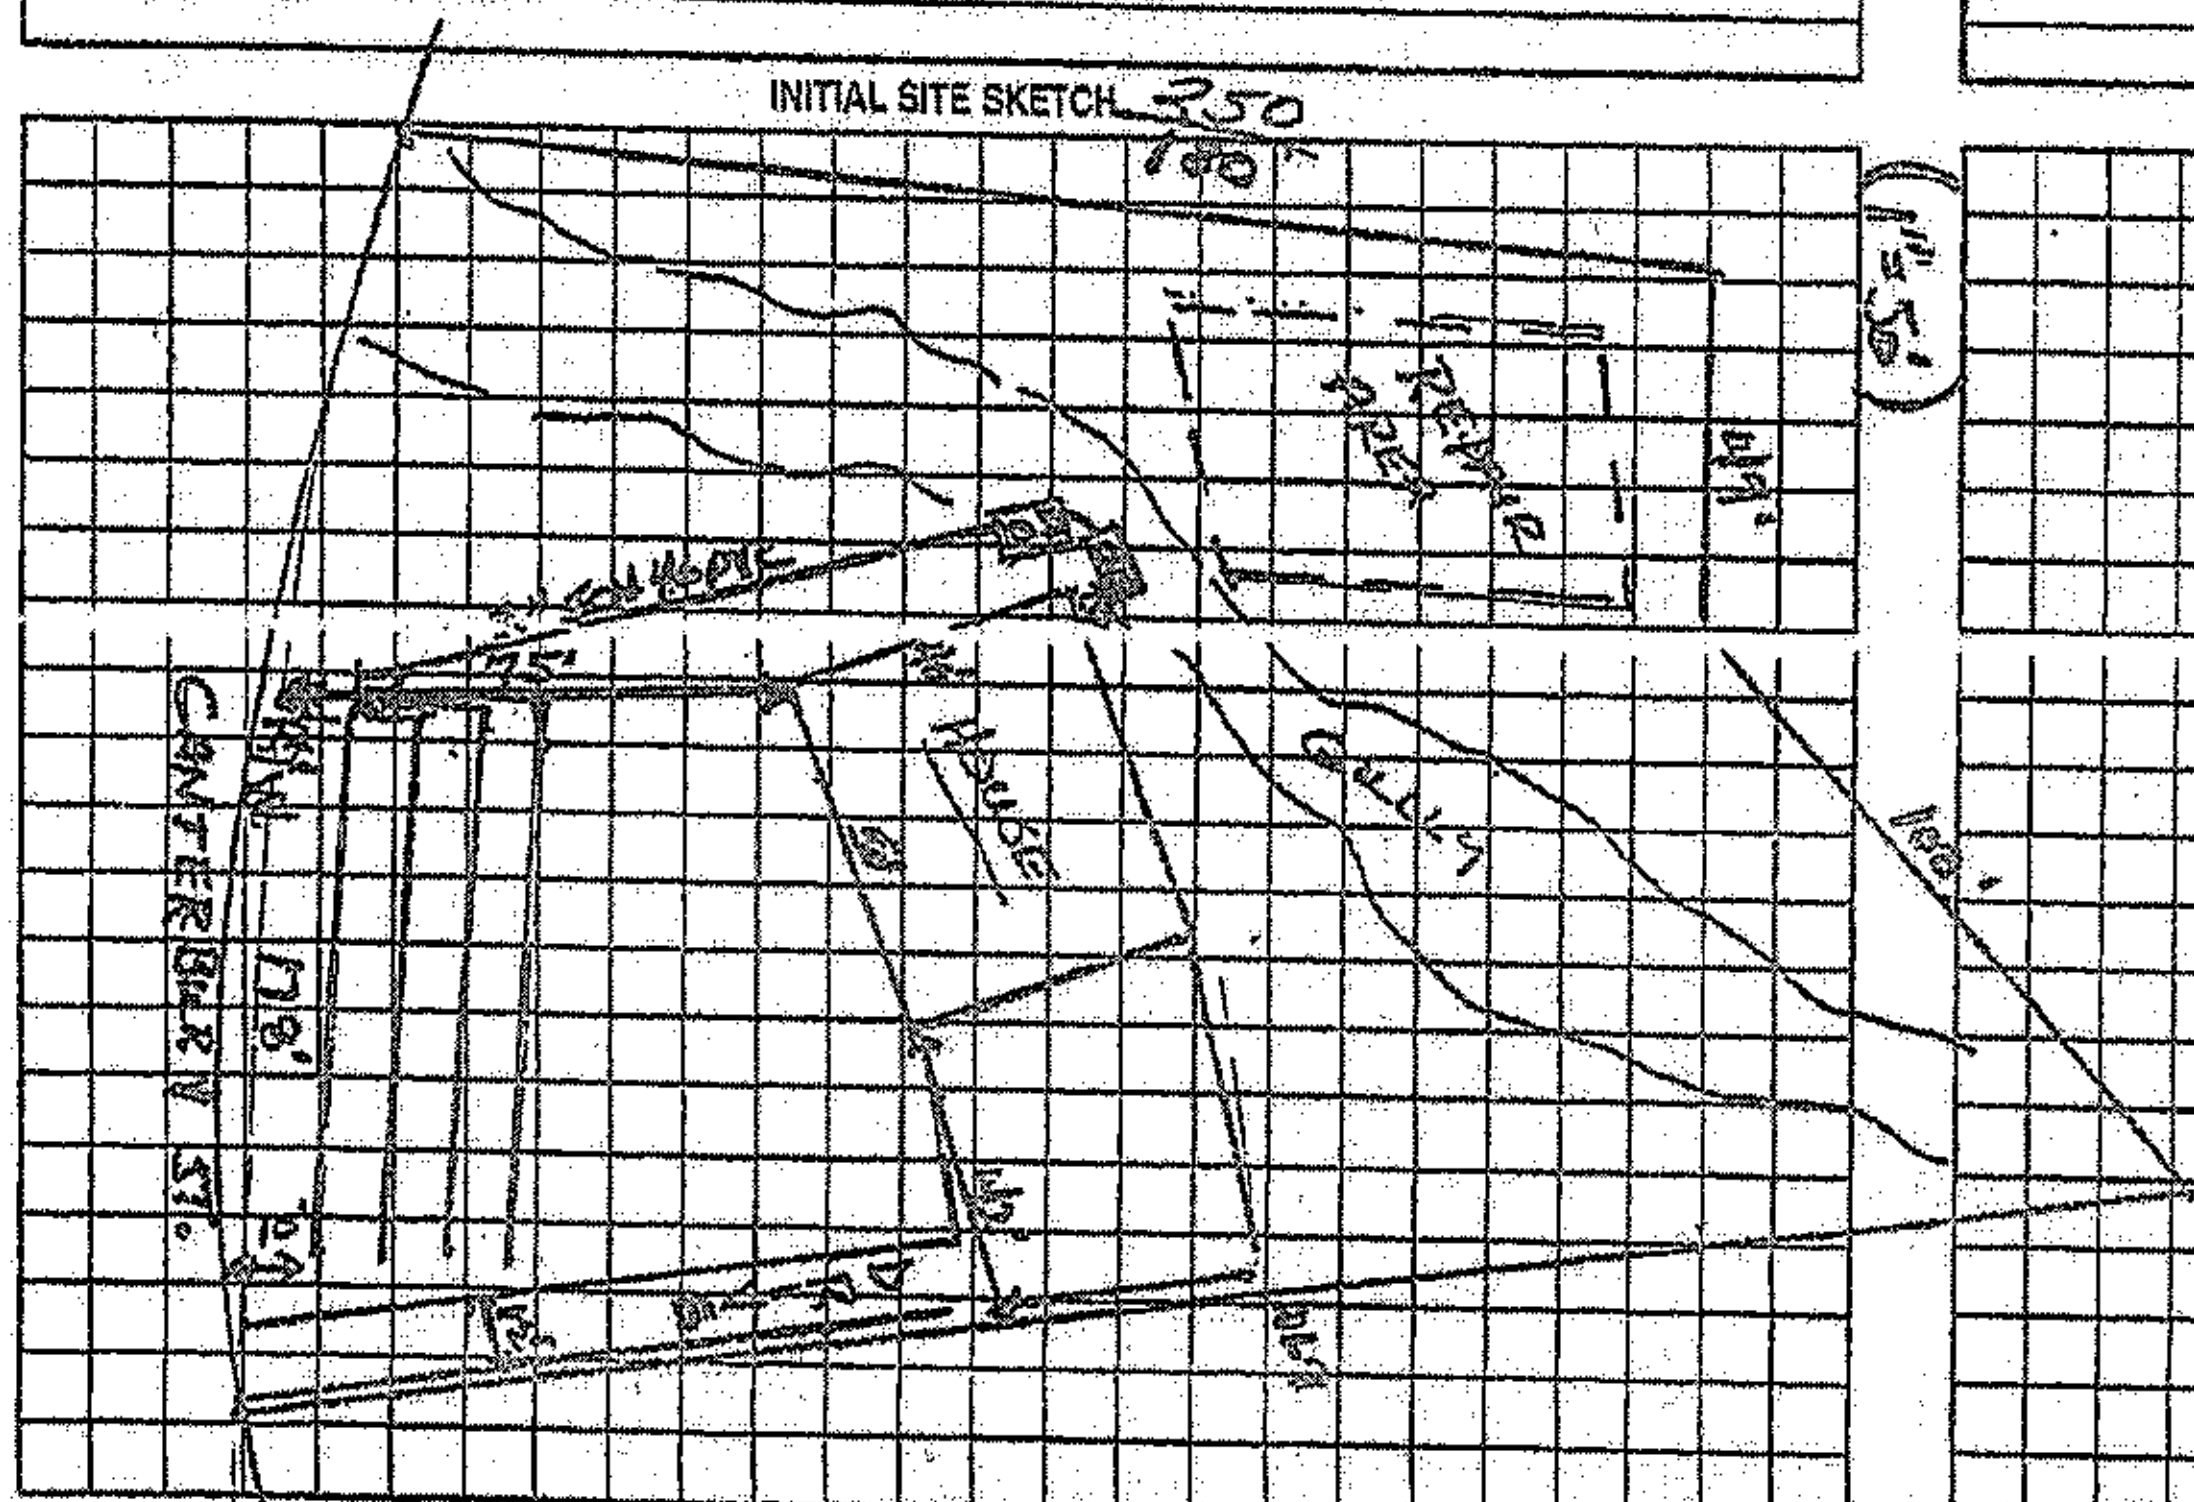

AS BUILT SKETCH

1999 Year
Proposed House & Septic Layout.

Permit can be suspended or revoked if any false information is supplied toward securing the permit/any unauthorized changes are made to the site/any unauthorized changes are made in the installation of the system. Improveme[nt] Permit with plat valid without expiration. Improvement Permit with site plan valid for sixty months. Authorization to Construct is valid for a period equal to that of Improvement Permit – not to exceed sixty months.

Signed: * Ray Moore date 12-10-99 Installed by:

Improvement Permit by: Wesley Sparks R.S. date 6/4/99 Operation Permit by: date

Authorization to Construct by: Wesley Sparks R.S. date 6/4/99 Existing System Inspection by: date

HEALTH DEPT. COPY: WHITE OWNER COPY (FINAL): YELLOW OWNER COPY (INITIAL): PINK