IREDELL COUNTY HEALTH DEPARTMENT

STATESVILLE 704-878-5305 MOORESVILLE 704-664-5281

IMPROVEMENT PERMIT / CERTIFICATE OF COMPLETION / OPERATION PERMIT / EXISTING SYSTEM INSPECTION

PROPERTY DESCRIPTION NO. 19629 DATE 10/31/94 TAX MAP NO. 1C 6 A 2-14 Watershed: ☐ Yes ☒ No

OWNER OR CONTRACTOR Leroy Deal PHONE: Business _____ Home 892-9730

ADDRESS 384 Presbyterian Rd. Mooresville, NC. 28115

LOCATION Presbyterian Rd (L) off 115 S to 2nd driveway (L) past Buckingham Place

SUBDIVISION Deals Land BLOCK / SECTION _____ LOT 2A LOT AREA ~1.15 SITE CLASS. P DESIGN FLOW 360 L.T.A.R. .35

Septic Tank: 1000 Gallons; STB _____ Date _____

Pump Tank: _____ Gallons; PT _____ Date _____

Pump Make: _____ Model _____ Serial No. _____

Nitrification Field: No Fields 1 Square Feet 1028 Linear Feet 350

No Lines 4 Trench Width 36" Max Trench Bottom Depth 32" Gravel Depth 12"

☒ New System ☐ Repair System Type: I, II, III, IV, V, VI

System Description: DROP BOX - CONV.

Repair System Description: _____

Maintenance Agreement Required: ☐ Yes ☒ No

☒ House/Mod. Home No. Bedrooms 3

☐ Mobile Home No. Bathrooms 1

☐ Business No. Employees _____

☐ Other _____


☐ Slab ☐ Crawl Space ☒ Basement w/plumbing ☐ Basement wo/plumbing

Water Supply: ☒ Individual ☐ Community ☐ Public

Comments:

Presbyterian Rd.


INITIAL SITE SKETCH

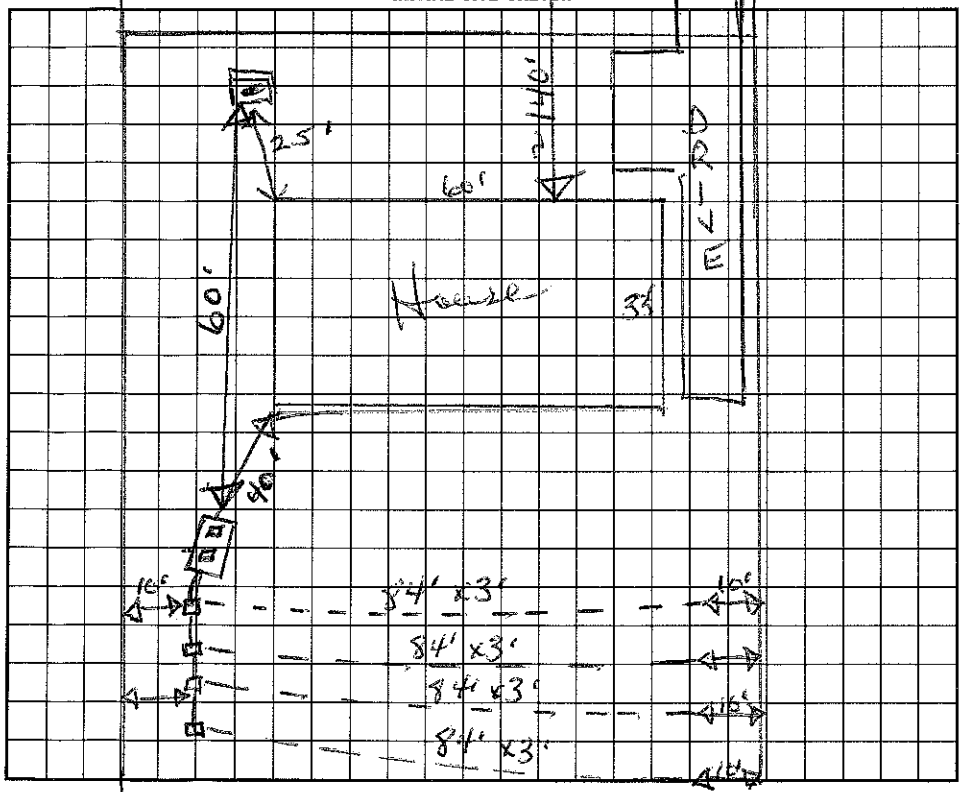

Comments:

2/23/95 - System changed since well not used - Deals well to be used.

AS BUILT SKETCH

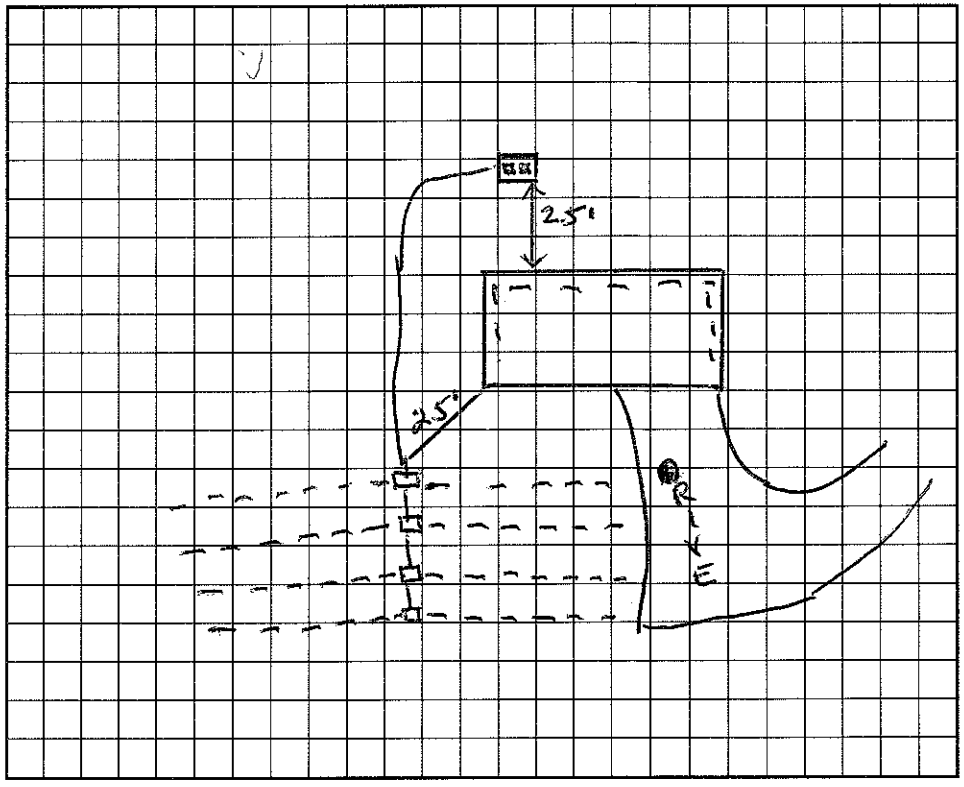

I understand that this permit can be suspended or revoked if any false information is supplied toward securing the permit/any unauthorized changes are made to the site/any unauthorized changes are made in the installation of the system. Improvement Permit is valid for 60 months from date of issuance.

Signed: _____

Improvement Permit by: Wesley Sparks RS. date 10/31/94

Existing System Inspection by: _____ date _____

Installed by: _____

Certificate of Completion by: _____ date _____

Operation Permit by: _____ date _____

HEALTH DEPT. COPY: WHITE INSPECTION COPY (FINAL): GREEN OWNER COPY (FINAL): YELLOW INSPECTION COPY (INITIAL): PINK OWNER COPY (INITIAL): GOLD