IREDELL COUNTY HEALTH DEPARTMENT

STATESVILLE 704-878-5205 MOORESVILLE 704-664-5281

IMPROVEMENT PERMIT / CERTIFICATE OF COMPLETION / OPERATION PERMIT / EXISTING SYSTEM INSPECTION

PROPERTY DESCRIPTION NO. 15554 DATE 3/11/94 TAX MAP NO. ~~4654 87~~ 4654 9710 4594 Watershed: ☒ Yes ☐ No

OWNER OR CONTRACTOR Curtis Kennedy PHONE: Business 704-331-0501 Home

ADDRESS Buckingham Pl. Mooresville, NC. 28115

LOCATION Davidson Downs - R Sixth From TL Buckingham, 8th Lot on (R)

SUBDIVISION Davidson Downs BLOCK / SECTION 1 LOT 87 LOT AREA ~.6 SITE CLASS. P DESIGN FLOW ~~360~~ L.T.A.R. .25

Septic Tank: 1000 Gallons; STB 358 Date 12/30/93

Pump Tank: 1-000 Gallons; PT Date 12/3/93

Pump Make: ZOELLER Model 161-0002 Serial No.

Nitrification Field: No Fields 1 Square Feet Linear Feet 240

No Lines 3 Trench Width 21 Max Trench Bottom Depth 30" Gravel Depth 6" STONE

☒ New System ☐ Repair System Type: I, II, III, IV, V, VI

System Description: Pressure Panel

Repair System Description:

Maintenance Agreement Required: ☒ Yes ☐ No

☒ House/Mod. Home No. Bedrooms 3

☐ Mobile Home No. Bathrooms 2.5

☐ Business No. Employees

☐ Other


☐ Slab ☐ Crawl Space ☐ Basement w/plumbing ☐ Basement wo/plumbing

Water Supply: ☒ Individual ☐ Community ☐ Public

Comments:

Comments:

AS BUILT ~~CUTTING~~ SITE SKETCH

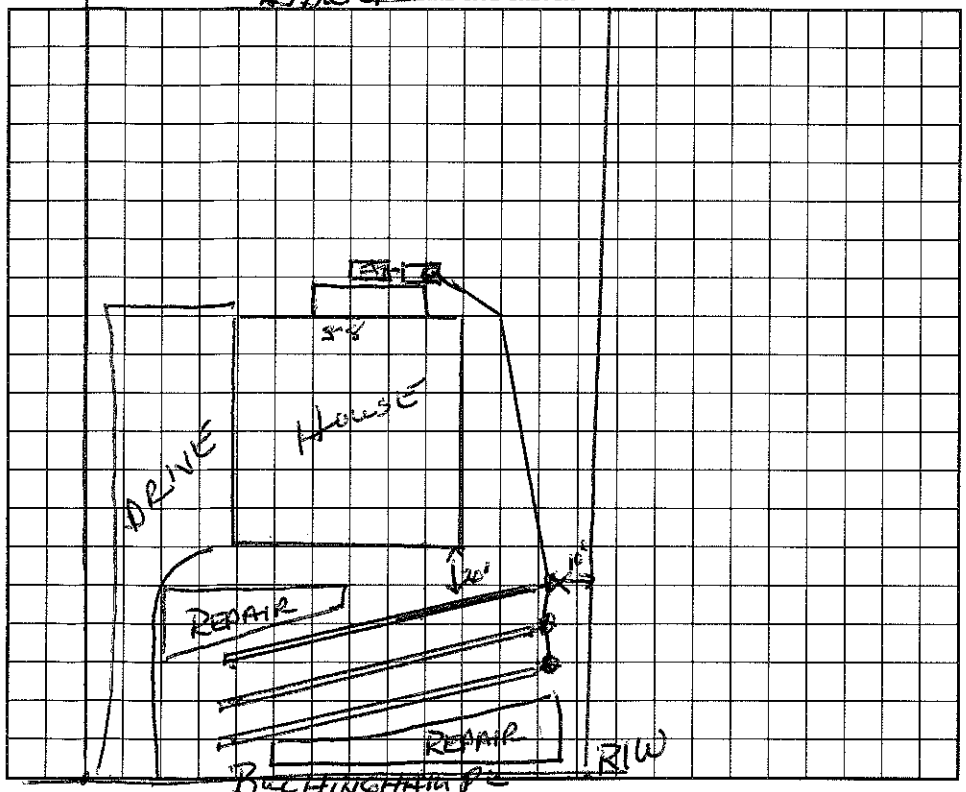

~~AS BUILT SKETCH~~

I understand that this permit can be suspended or revoked if any false information is supplied toward securing the permit/any unauthorized changes are made to the site/any unauthorized changes are made in the installation of the system. Improvement Permit is valid for 60 months from date of issuance.

Signed:

Improvement Permit by: date

Existing System Inspection by: date

Installed by: Julian Bowles

Certificate of Completion by: Wesley Sparkes date 3/18/94

Operation Permit by: Wesley Sparkes date 3/18/94

HEALTH DEPT. COPY: WHITE INSPECTION COPY (FINAL): GREEN OWNER COPY (FINAL): YELLOW INSPECTION COPY (INITIAL): PINK OWNER COPY (INITIAL): GOLD