PIN# 4654-97-1268

IREDELL COUNTY HEALTH DEPARTMENT

Const Auth STATESVILLE 704-878-5305 MOORESVILLE 704-664-5281

IMPROVEMENT PERMIT / ~~CERTIFICATE OF COMPLETION~~ / OPERATION PERMIT / EXISTING SYSTEM INSPECTION

PROPERTY DESCRIPTION NO. 067960 DATE July 11, '97 TAX MAP NO. 4659866990 Watershed: ☐ Yes ☐ No

OWNER OR CONTRACTOR Raymond E. Hobbs PHONE: Business _____ Home _____

ADDRESS 226 Buckingham Dr. Rd. Mooresville

LOCATION 1155 - Tr Presbyterian TR Santa Fann TL Downing TR Canterbury ~3rd on left

SUBDIVISION Davidson Woods BLOCK / SECTION _____ LOT 95 LOT AREA ~30,080 ft² SITE CLASS. PS DESIGN FLOW 360 gpd L.T.A.R. @3

Septic Tank: 1000 Gallons; STB Tuf Date 3/2/98

Pump Tank: _____ Gallons; PT _____ Date _____

Pump Make: _____ Model _____ Serial No. _____

Nitrification Field: No Fields 1 Square Feet 400 Linear Feet 200

No Lines 4@50 Trench Width 24" Max Trench Bottom Depth ~30" Gravel Depth NA

☑ New System ☐ Repair System Type: I, II, III, IV, V, VI

System Description: gravity panel block

Repair System Description: ~~repair~~ pumped panel/Chamb

Maintenance Agreement Required: ☐ Yes ☐ No

☑ House/Mod. Home No. Bedrooms 3

☐ Mobile Home No. Bathrooms 2

☐ Business No. Employees _____

☐ Other _____

☐ Slab ☑ Crawl Space ☐ Basement w/plumbing ☐ Basement wo/plumbing


Water Supply:
☐ Individual
☑ Community
☐ Public

Comments:

Comments:

1" = 100'

INITIAL SITE SKETCH

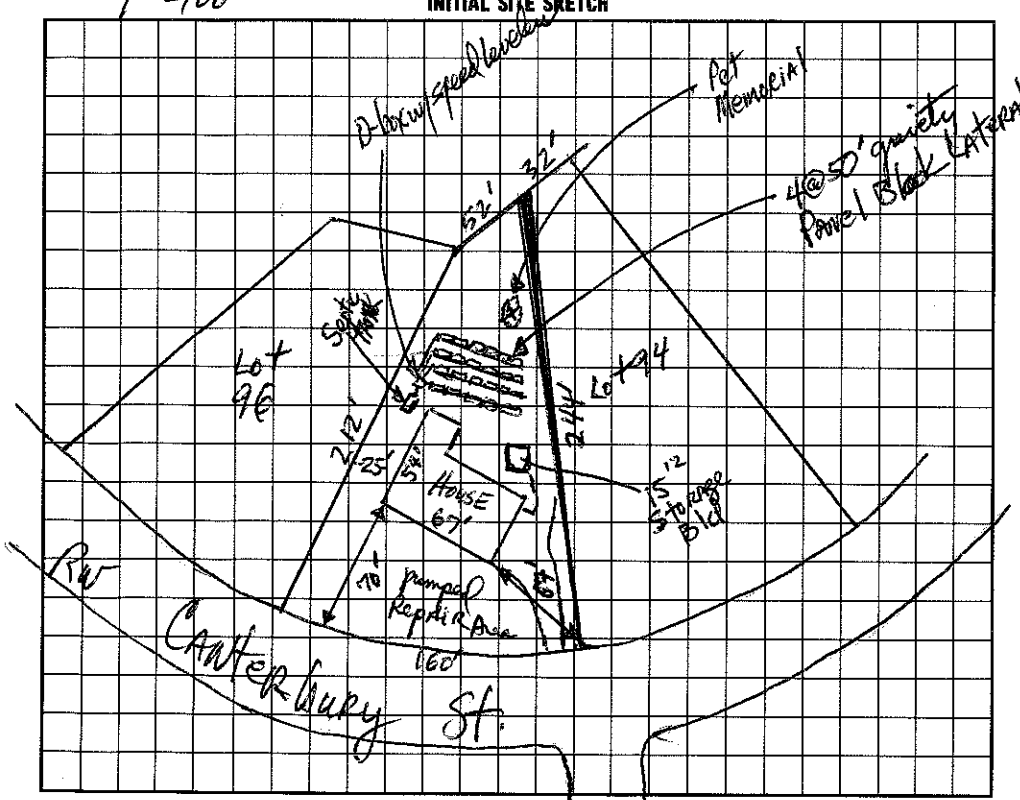

AS BUILT SKETCH

I understand that this permit can be suspended or revoked if any false information is supplied toward securing the permit/any unauthorized changes are made to the site/any unauthorized changes are made in the installation of the system. Improvement Permit is valid for 60 months from date of issuance.

Signed: Margaret Hobbs

Improvement Permit by: DR Thompson RS date 7-11-97

~~Existing System~~ Construction Inspection by: DR Thompson RS date 7-11-97

Installed by: DENVER RUMBLE

Certificate of Completion by: _____ date _____

Operation Permit by: [signature] date 5/16/98

As Through

HEALTH DEPT. COPY: WHITE INSPECTION COPY (FINAL): GREEN OWNER COPY (FINAL): YELLOW INSPECTION COPY (INITIAL): PINK OWNER COPY (INITIAL): GOLD