PN# 4654-97-1268 11 00

IREDELL COUNTY HEALTH DEPARTMENT

STATESVILLE 704-878-5305 MOORESVILLE 704-664-5281

IMPROVEMENT PERMIT / CERTIFICATE OF COMPLETION / OPERATION PERMIT / EXISTING SYSTEM INSPECTION

PROPERTY DESCRIPTION NO. 20909 DATE 5/1/95 TAX MAP NO. 1C 2 A 90 Watershed: ☐ Yes ☑ No

OWNER OR CONTRACTOR Ray Mayley PHONE: Business Home 892-3747

ADDRESS 267 Canterbury St. Mooresville, NC. 28115

LOCATION Canterbury St. on (L) before Ray Mayley's house

SUBDIVISION Davidson Downs BLOCK / SECTION 1 LOT 99 LOT AREA ~ 3/4 acre SITE CLASS. P DESIGN FLOW 360 L.T.A.R. .3

Septic Tank: 1000 Gallons; STB 794 Date 7/7/97

Pump Tank: Gallons; PT Date

Pump Make: Model Serial No.

Nitrification Field: No Fields 1 Square Feet 1200 Linear Feet * 300

No Lines 3 Trench Width 36 Max Trench Bottom Depth 36" Gravel Depth N/A

☑ New System ☐ Repair System Type: I, II, ☑ III, IV, V, VI

System Description: INFILTRATOR

Repair System Description:

Maintenance Agreement Required: ☐ Yes ☑ No

☑ House/Mod. Home No. Bedrooms 3

☐ Mobile Home No. Bathrooms 2

☐ Business No. Employees

☐ Other


☐ Slab ☑ Crawl Space ☐ Basement w/plumbing ☐ Basement wo/plumbing

Water Supply: ☐ Individual ☑ Community ☐ Public

Comments: * 30" TALL INFILTRATOR DRAINFIELD ON CONTOURS.

Comments:

INITIAL SITE SKETCH

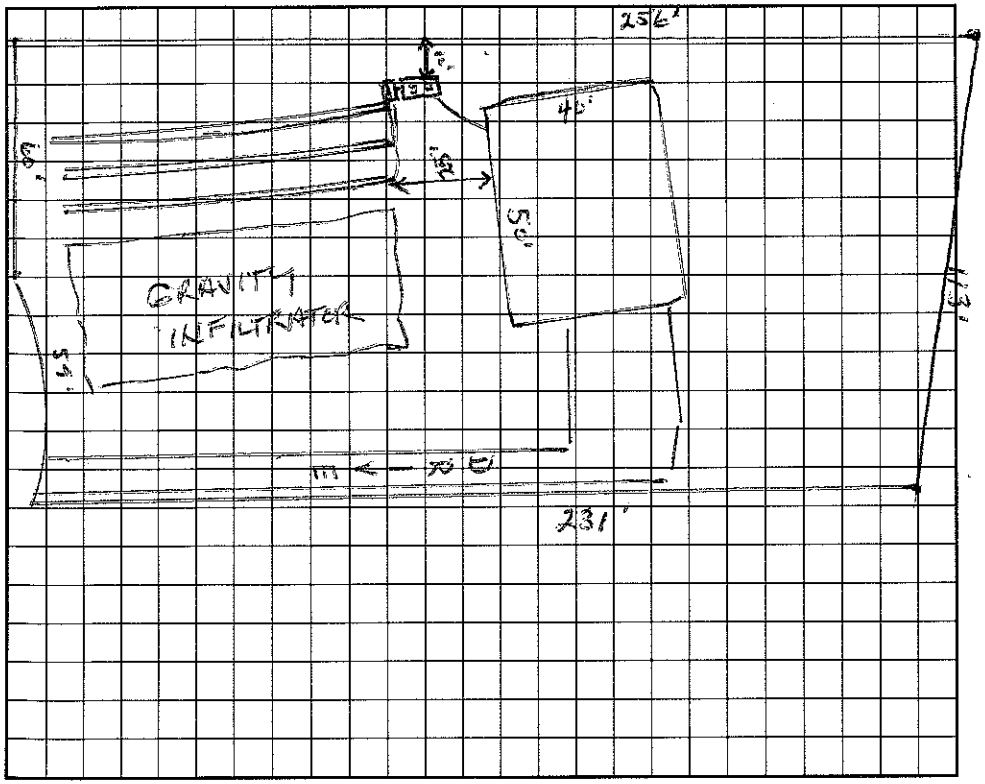

AS BUILT SKETCH

I understand that this permit can be suspended or revoked if any false information is supplied toward securing the permit/any unauthorized changes are made to the site/any unauthorized changes are made in the installation of the system. Improvement Permit is valid for 60 months from date of issuance.

Signed: Ray Mayley

Improvement Permit by: Wesley Sparks RS date 5/1/95

Existing System Inspection by: date

Installed by: Julian Bowles

Certificate of Completion by: Wesley Sparks RS. date 9/18/97

Operation Permit by: Wesley Sparks RS date 9/18/97

HEALTH DEPT. COPY: WHITE INSPECTION COPY (FINAL): GREEN OWNER COPY (FINAL): YELLOW INSPECTION COPY (INITIAL): PINK OWNER COPY (INITIAL): GOLD