4.00

IREDELL COUNTY HEALTH DEPARTMENT

AUTHORIZATION TO CONSTRUCT

10:30

STATESVILLE 704-878-5305 MOORESVILLE 704-664-5281

IMPROVEMENT PERMIT / ~~CERTIFICATE OF COMPLETION~~ / OPERATION PERMIT / EXISTING SYSTEM INSPECTION

PROPERTY DESCRIPTION NO. 24288 DATE 8/15/96 TAX MAP NO. 1L-6-A-4 Watershed: ☐ Yes ☑ No

OWNER OR CONTRACTOR RICH PASTOR ~~PRONG: Business~~ 4654-98-6445 Home 863-7273

ADDRESS 17449 TAWNY LANE HUNTERSVILLE NC

LOCATION 115 S-TL PRESBYTERIAN RD-ON RT BEFORE ROCKY RIVER

SUBDIVISION HILL CREEK SUBD BLOCK / SECTION ____ LOT 4 LOT AREA ____ SITE CLASS. PS DESIGN FLOW 360GPD L.T.A.R. .3 GPD/FT²

Septic Tank: 1000 Gallons; STB 794 Date 10/30/96

Pump Tank: ____ Gallons; PT ____ Date ____

Pump Make: ____ Model ____ Serial No. ____

Nitrification Field: No Fields 1 Square Feet 900 Linear Feet 300

No. Lines 5 Trench Width 36" Max Trench Bottom Depth 36" Gravel Depth N/A

☑ New System ☐ Repair System Type: I, II, (III), IV, V, VI

System Description: GRAVITY CHAMBERED

Repair System Description: PUMP PANEL

Maintenance Agreement Required: ☐ Yes ☑ No

☑ House/Mod. Home No. Bedrooms 3

☐ Mobile Home No. Bathrooms 2

☐ Business No. Employees ____

☐ Other ____

☐ Slab ☑ Crawl Space ☐ Basement w/plumbing ☐ Basement wo/plumbing

Water Supply: ☑ Individual ☐ Community ☐ Public


Comments:

Move house back - (System in front)


Will change to ~~Cut~~ BACK - (C.G.P.)

Comments:

INITIAL SITE SKETCH 1"=50'

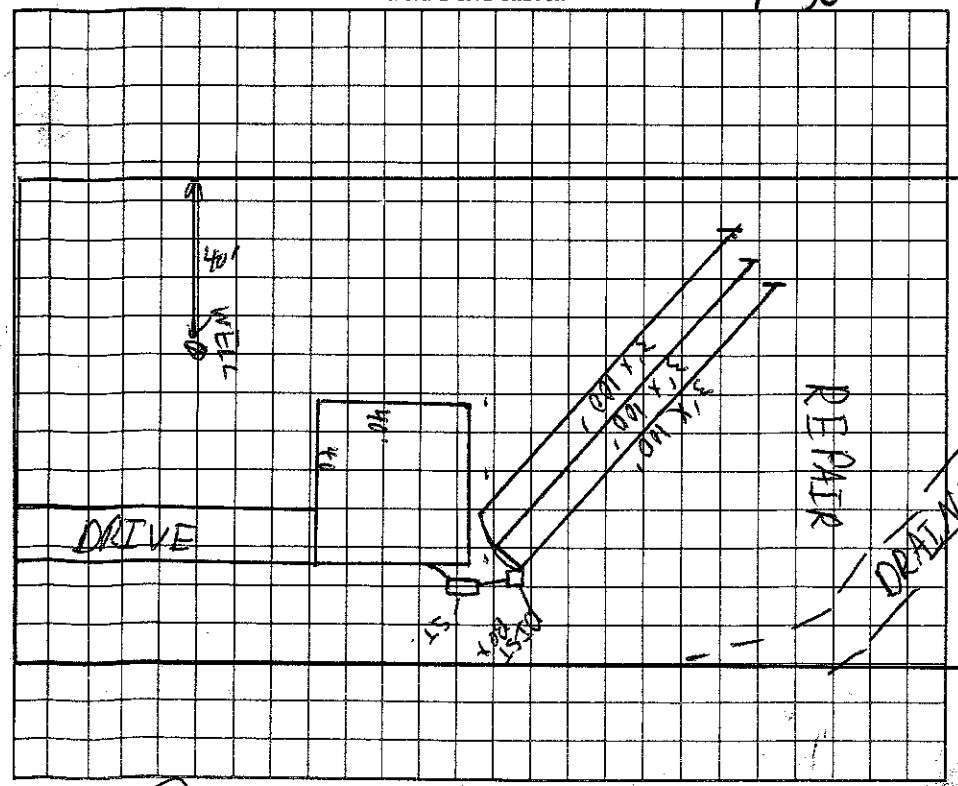

AS BUILT SKETCH

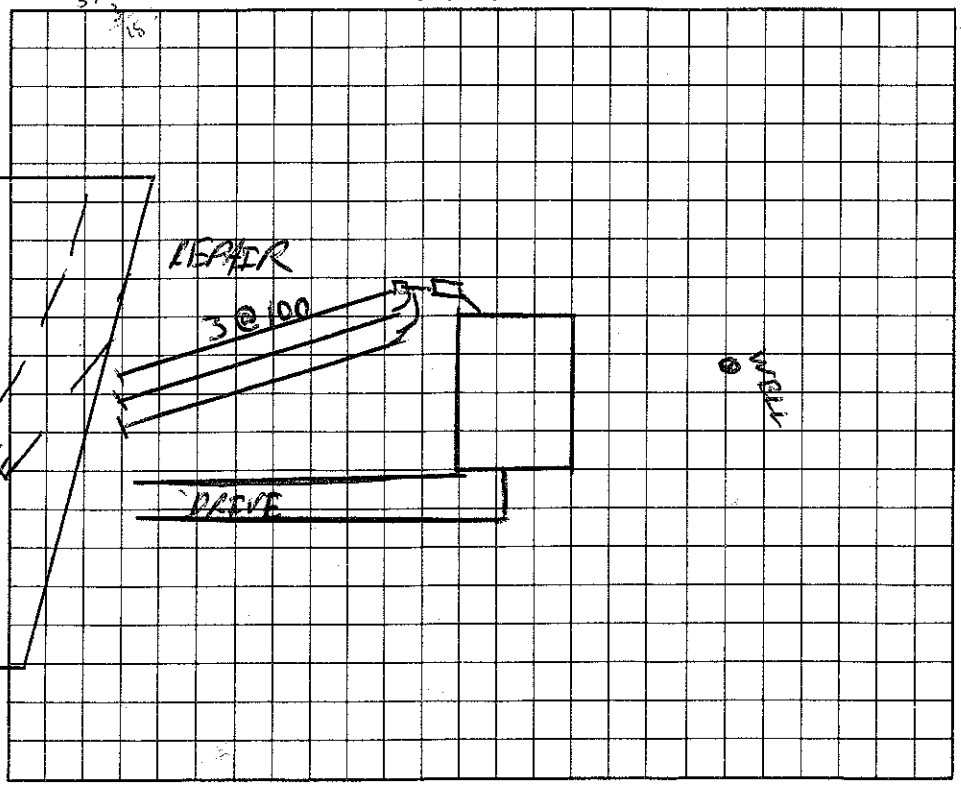

I understand that this permit can be suspended or revoked if any false information is supplied toward securing the permit/any unauthorized changes are made to the site/any unauthorized changes are made in the installation of the system.

Signed: Richard M Pastor

Improvement Permit by: C. Ruby Teem EHSE date 8/15/96

~~Existing System Inspection~~ CONSTRUCTION by: C. Ruby Teem EHSI date 8/19/96

AUTHORIZATION

Installed by: CLINT DUNNING

Certificate of Completion by: ____ date ____

Operation Permit by: C. Ruby Teem date 10/31/96

HEALTH DEPT. COPY: WHITE INSPECTION COPY (FINAL): GREEN OWNER COPY (FINAL): YELLOW INSPECTION COPY (INITIAL): PINK OWNER COPY (INITIAL): GOLD