IREDELL COUNTY HEALTH DEPARTMENT

Statesville Office (704) 878-5305 Mooresville Office (704) 660-3625 PERMIT # 210954

IMPROVEMENT PERMIT / AUTHORIZATION TO CONSTRUCT / OPERATION PERMIT / EXISTING SYSTEM

PIN # 4654982592

APPLICANT: Michael Flemming APPLICANT ADDRESS: 1438 Presbyterian Rd Mooresville, NC. 28115

SITE ADDRESS: Same PHONE: ALT. PHONE:

SITE DIRECTIONS: 1155 TL Presbyterian, last house on (R) before creek

SUBDIVISION: Hellcreek SECTION: LOT # 1 + 2 LOT AREA: .97 DESIGN FLOW: L.T.A.R.:

Septic Tank 1000 (gal) STB Date
Pump Tank (gal) PT Date
Pump Make Model Serial #
Nitrification Fields 1 # Lines 4 Linear Ft: 200
Trench Width 2' Max. Trench Bottom Depth Gravel Depth


☐ New System ☐ Repair ☐ Expansion System Type: I II (III) IV V VI
System Description: EXISTING - 16" PANEL Block
Repair System Description:
Maintenance Agreement Required: ☐ YES ☑ NO
☑ GRAVITY ☐ PRESSURE

☑ Residence ☐ Business ☐ Other ☐ Slab ☐ Basement w/plumbing
No. Bedrooms 3 No. Persons No. Employees ☑ Crawl Space


Water Supply: ☑ Private ☐ Public ☐ Community
☐ Basement w/o plumbing

Comments / Conditions: Building does not impact Septic System for this property.

INITIAL SITE SKETCH

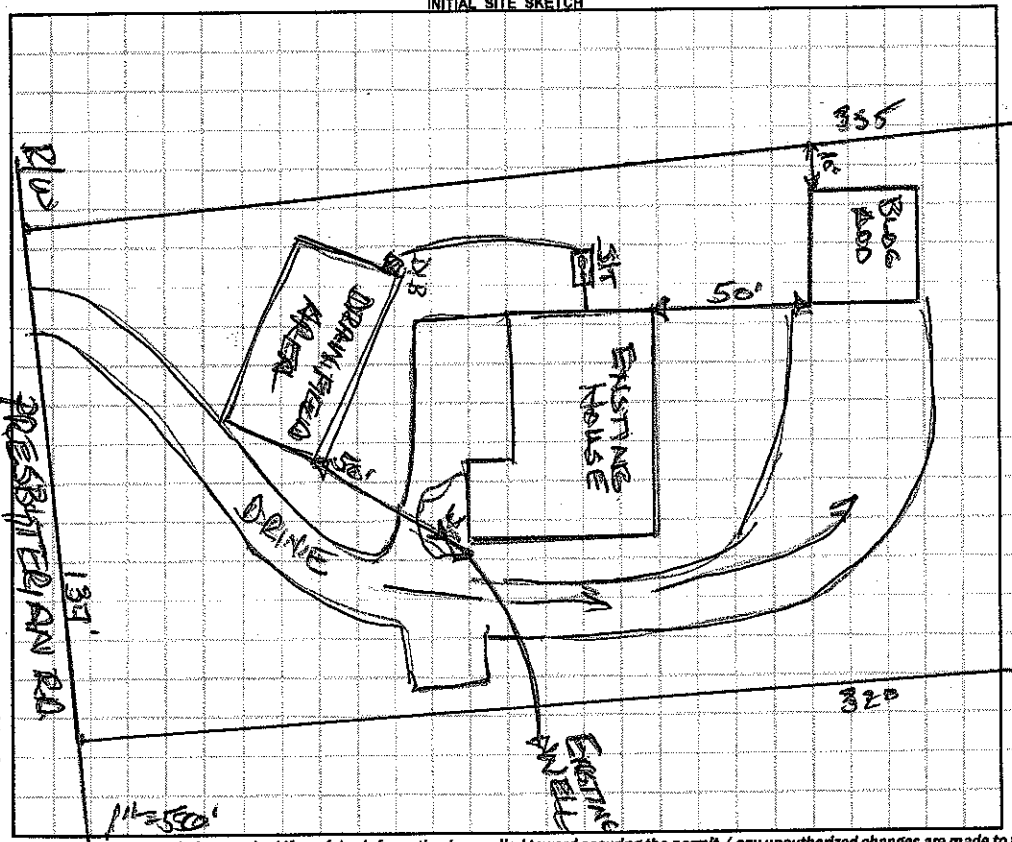

AS BUILT SKETCH

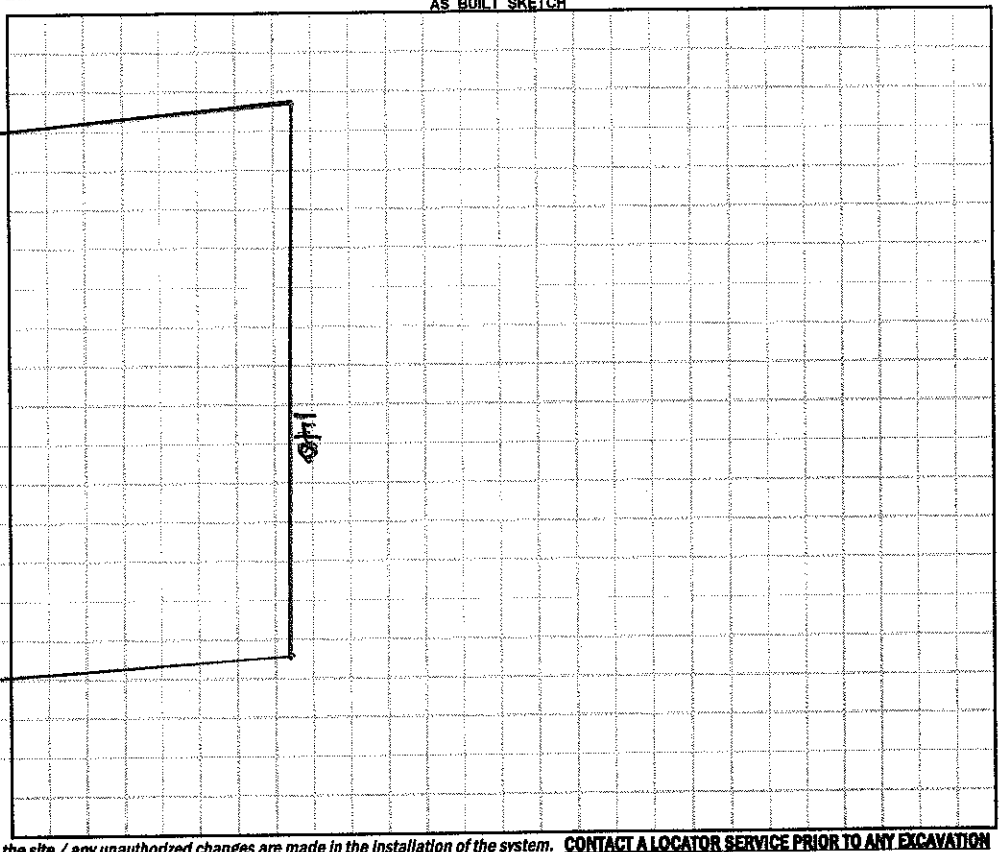

Permit can be suspended or revoked if any false information is supplied toward securing the permit / any unauthorized changes are made to the site / any unauthorized changes are made in the installation of the system. **CONTACT A LOCATOR SERVICE PRIOR TO ANY EXCAVATION**

☐ **IMPROVEMENT PERMIT** *with plat valid without expiration.* ☐ **IMPROVEMENT PERMIT** *with site plan valid for 60 mos.* ☐ **AUTHORIZATION TO CONSTRUCT** *valid for period equal to IMPROVEMENT PERMIT--not to exceed 60 mo.*

Owner / Applicant Signature: Michael D. Flemming Date: 6-23-15 Installed by:

IMPROVEMENT PERMIT by: Date: OPERATION PERMIT by: Date:

AUTHORIZATION TO CONSTRUCT by: Date: Existing System Inspected by: Wesley Sparks Date: 6/23/2015

Health Dept. Copy - WHITE Applicant (Final Approval) - YELLOW Applicant (Conditional Approval) - PINK