IREDELL COUNTY HEALTH DEPARTMENT

STATESVILLE 704-878-5305 MOORESVILLE 704-664-5281

(11.30)

IMPROVEMENT PERMIT / AUTHORIZATION TO CONSTRUCT / OPERATION PERMIT / EXISTING SYSTEM INSPECTION

PERMIT# 082172 PIN# 4664 28 7188 PT. 4654-98-3074 DATE 7/29/99

OWNER OR CONTRACTOR Anne McIntosh PHONE: Business 896-3488 Home

ADDRESS PO Box 1961 Davidson, NC. 28036

LOCATION 115-21 S TL Presbyterian Rd. TR Davidson Ridge Lane, to cul de sac, (Lot straight ahead on cul de sac

SUBDIVISION Davidson Ridge BLOCK / SECTION 3 LOT 14 LOT AREA ~ 1.21 AC SITE CLASS. PS DESIGN FLOW 360 L.T.A.R. .3

Septic Tank: 1000 Gallons; STB 312 Date 8/30/99
Pump Tank: Gallons; PT Date
Pump Make: Model Serial No.
Nitrification Field: No Fields 1 Square Feet 900* Linear Feet 300*
No Lines 3 or 4 Trench Width 36" Max Trench Bottom Depth 36" Gravel Depth SAND.


☒ New System ☐ Repair System Type: I, II, (III) IV, V, VI
System Description: Gravity Ch. Plastic on HOS
Repair System Description: Pressure - 16" PDBS
Maintenance Agreement Required: ☐ Yes ☒ No

☒ House/Mod. Home No. Bedrooms 3
☐ Mobile Home No. Bathrooms 2.5
☐ Business No. Employees
☐ Other
☐ Slab ☒ Crawl Space ☐ Basement w/plumbing ☐ Basement wo/plumbing

Water Supply:
☒ Individual
☐ Public
☐ Community


Comments:/Conditions:

INITIAL SITE SKETCH

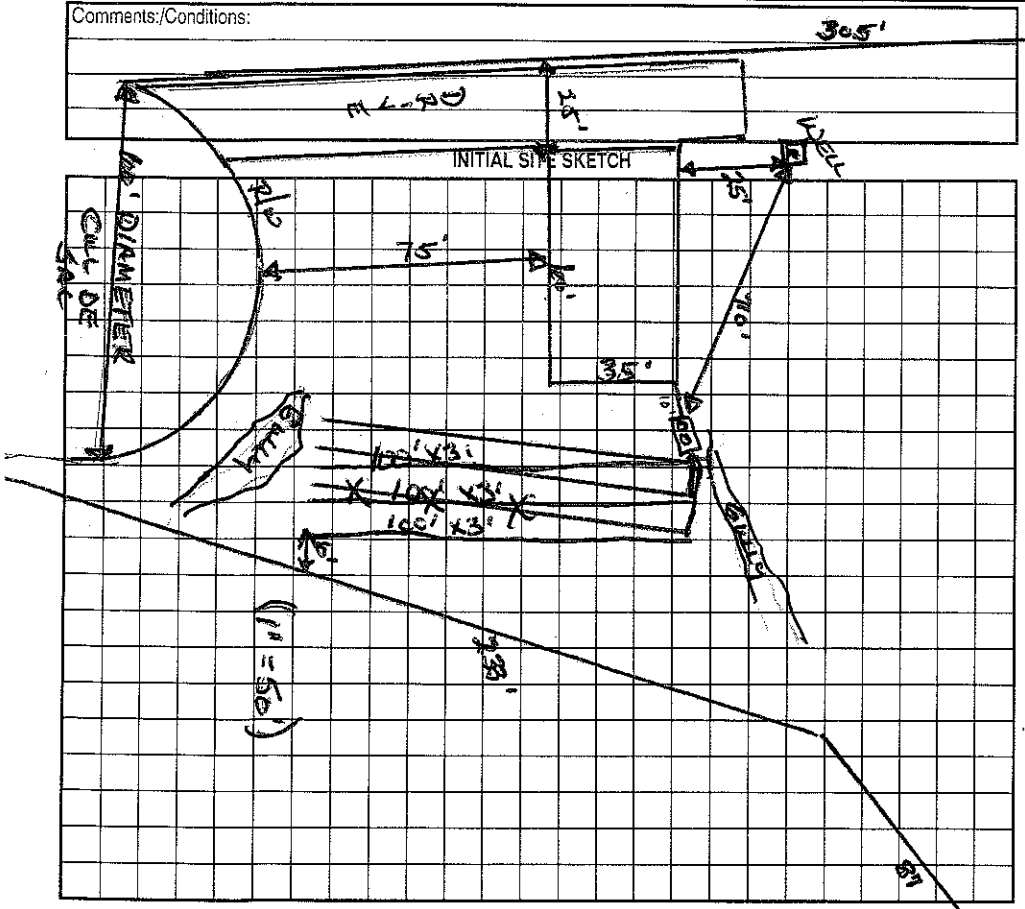

Comments:/Conditions:

AS BUILT SKETCH

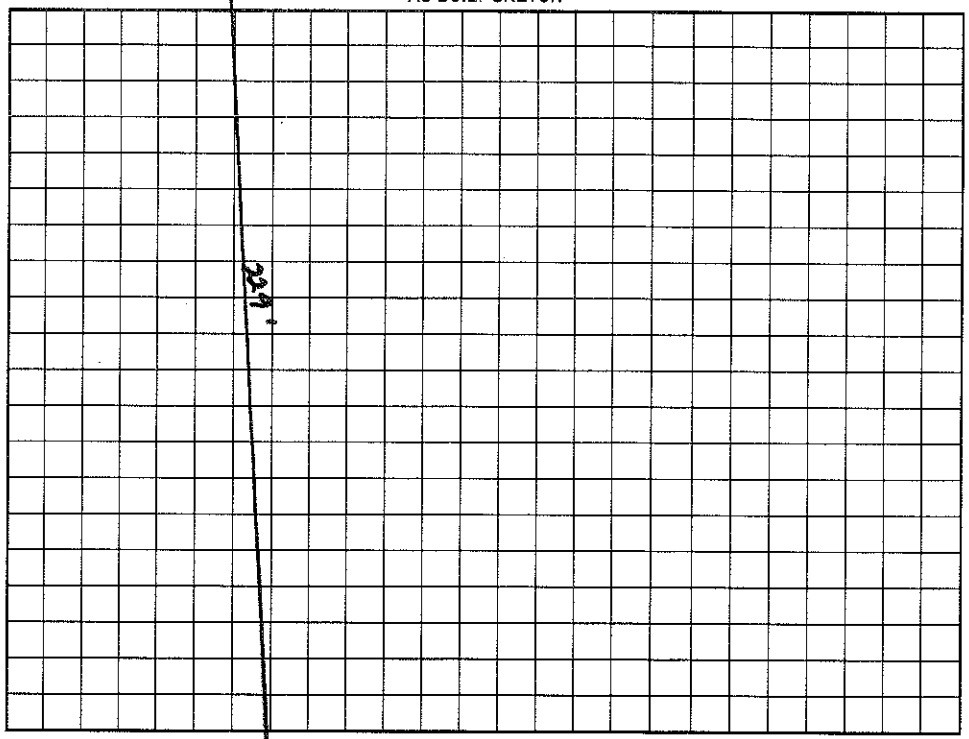

Permit can be suspended or revoked if any false information is supplied toward securing the permit/any unauthorized changes are made to the site/any unauthorized changes are made in the installation of the system. Improvement Permit with plat valid without expiration. Improvement Permit with site plan valid for sixty months. Authorization to Construct is valid for a period equal to that of Improvement Permit – not to exceed sixty months.

Signed: Anne McIntosh date 8/02/99 Installed by: Wayne Osborn Const Co.

Improvement Permit by: Wesley Sparks RS. date 7/29/99 Operation Permit by: Wesley Sparks RS date 3/9/00

Authorization to Construct by: Wesley Sparks RS. date 7/29/99 Existing System Inspection by: date

HEALTH DEPT. COPY: WHITE OWNER COPY (FINAL): YELLOW OWNER COPY (INITIAL): PINK